

MONTGOMERY
K 2006

MISSISSIPPI DEPARTMENT OF NATURAL RESOURCES
Bureau of Land and Water Resources
Southport Mall
P.O. Box 10631
Jackson, Mississippi 39209
WATER WELL DRILLERS LOG

11-7 1985
date well completed

Thomas & Son
firm name

Montgomery CO
county well located

LANDOWNER: X.L. Love
Rt 2
Klanchoel Miss
(mailing address)
WELL LOCATION:
sec. 31 T. 18 N. R. 7 E
5 miles SE Klanchoel
(distance) (direction) (nearest town)

| description of formations encountered | from | to |
|---------------------------------------|-----------------|-----------|
| | <u>Red DIRT</u> | <u>0</u> |
| <u>Red Sand</u> | <u>4</u> | <u>10</u> |
| <u>Grey Chalk</u> | <u>10</u> | <u>18</u> |
| <u>White Sand</u> | <u>18</u> | <u>26</u> |
| <u>Grey Chalk</u> | <u>26</u> | <u>54</u> |
| <u>White C. Sand</u> | <u>54</u> | <u>83</u> |

WELL PURPOSE:
(home, irrigation, municipal, industrial)

- WELL COMPLETION DATA:
- (1) diameter (inches) 2"
 - (2) total depth (feet) 83'
 - (3) static water level (feet) 28 below top of ground.
 - (4) casing PVC, 83',
(material) (depth)
2" if telescope see back.
(size)
 - (5) screen 10', 73',
(length) (depth to top)
2", PVC
(size) (material)
 - (6) pump 1, 8
(HP) (yield gpm)
Electric
(type power)
 - (7) electric log No
(yes or no)
(organization running log)
 - (8) how well bottom plugged Screen


DRILLERS REMARKS:

RECEIVED
NOV 1 9 1985

Department of Natural Resources
Bureau of Land & Water Resources

If well telescopes please sketch and show depths.

GROUND LEVEL

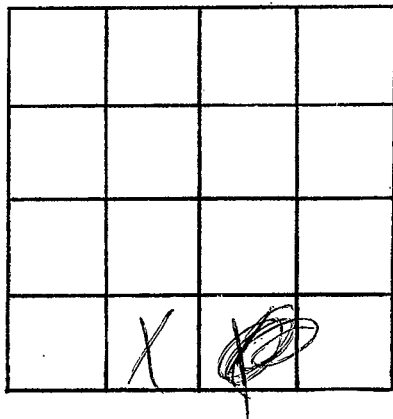

SECTION _____

Please indicate well location X.

ADDITIONAL INFORMATION

If more than one screen,
show locations of each on sketch.