

Montgomery
L 5
4-18-72

MISSISSIPPI
BOARD OF WATER COMMISSIONERS
416 North State Street
Jackson, Mississippi 39201

CODED

WATER WELL DRILLERS LOG

4-18 1972 Thomson & Son Montgomery
date well completed firm name county well located


LANDOWNER: <u>Charles Fulkerson</u>	description of formations encountered	from	to
<u>Stewart, Miss</u> (mailing address)	<u>Red Clay</u>	<u>0</u>	<u>8</u>
WELL LOCATION: sec. <u>4</u> T. <u>13N</u> R. <u>8E</u> <u>1</u> miles <u>W</u> of <u>Stewart</u> (distance) (direction) (nearest town)	<u>Pipe Clay</u>	<u>8</u>	<u>20</u>
WELL PURPOSE: <u>Dairy Barn</u> (home, irrigation, municipal, industrial)	<u>Grey Chalk</u>	<u>20</u>	<u>58</u>
WELL COMPLETION DATA:	<u>Coarse water sand</u>	<u>58</u>	<u>71</u>
(1) diameter (inches) <u>2</u>	<u>Green Chalk soft</u>	<u>71</u>	<u>137</u>
(2) total depth (feet) <u>315</u>	<u>Hard Black dirt</u>	<u>137</u>	<u>160</u>
(3) static water level (feet) <u>63</u> <u>below</u> above top of ground.	<u>Silt & Black dirt</u>	<u>160</u>	<u>197</u>
(4) casing <u>Galv.</u> <u>147</u> (material) (depth)	<u>Hard</u>	<u>197</u>	<u>209</u>
<u>2</u> If telescope see back. (size)	<u>Soft</u>	<u>209</u>	<u>216</u>
(5) screen <u>open</u> (length) (depth to top)	<u>Green Chalk & little</u>	<u>216</u>	<u>315</u>
(size) (material)	<u>Streaks Fine Greenish Sand.</u>		
(6) pump <u>2</u> <u>10</u> (HP) (yield gpm)			
<u>Elec</u> (type power)			
(7) electric log <u>NO</u> (yes or no)			
(organization running log)			
(8) how well bottom plugged <u>open</u>			
DRILLERS REMARKS:			

CODED

APR 2 1972

If well telescopes please sketch and show depths.

GROUND LEVEL

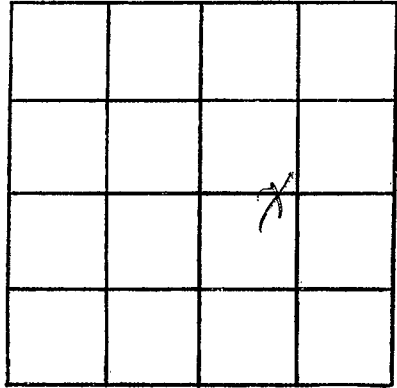

SECTION 4

Please indicate well location X.

ADDITIONAL INFORMATION

If more than one screen,
show locations of each on sketch.