

BOHERRY

L6
5-1-62

WATER WELL DRILLERS LOG

CODED

mountain

Date: May 1, 1962, Driller: Braswell Dilger County: Attala
(Name) V

(1) Owner of Land: Chas. Fondren
(Name)
Stewart Miss
(Address)

(2) Location: 1/4, 1/4, Sec. 3 18 8 T R
1 1/2 miles West, of Stewart
(distance) (direction) (Nearest Town)

(3) Topography: Hilly
(Hilly) (Flat) (Level)

(4) Purpose of Well: Domestic
(Domestic Irrigation
Municipal, Industrial, Other)

Description & Color of Materials Sand, Clay, Red Clay, Shell, etc.	Thick- ness Feet	Depth Feet
<u>Red Clay</u>	<u>30</u>	<u>30</u>
<u>Sand</u>	<u>20</u>	<u>50</u>
<u>White Chalk</u>	<u>10</u>	<u>60</u>
<u>Black Shale</u>	<u>63</u>	<u>123</u>
<u>Gray Sand</u>	<u>7</u>	<u>130</u>
<u>Black Shale</u>	<u>55</u>	<u>285</u>
<u>Gray Sand</u>	<u>30</u>	<u>315</u>

Information upon completion of well:

(1) Diameter 2 inches.

(2) Total Depth 315 feet.

(3) Water Level 70 feet below top of ground.

(4) Cased to _____, Size _____.


(5) Screen: Size _____, Length _____.

(6) Were any formations sealed against pollution?
_____ yes, _____ no.

CODED

If YES, depth of formation _____
Why _____

Drillers Remarks: Method of
Casing & Screening
A trade secret

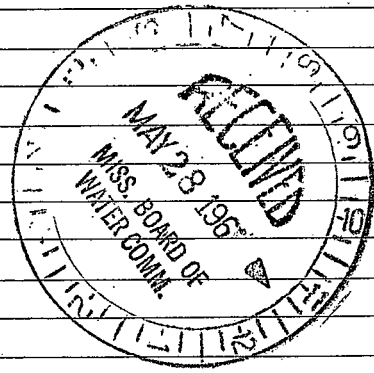

(Use Back Side)

Well No.

MONTH