

Montgomery
L 7
4-25-72

MISSISSIPPI
 BOARD OF WATER COMMISSIONERS
 416 North State Street
 Jackson, Mississippi 39201

CODED

WATER WELL DRILLERS LOG

4-25 1972 Thomas & Son Montgomery
 date well completed firm name county well located

LANDOWNER: <u>E. L. Rivers</u> <u>Stewart, Miss</u> (mailing address)	description of formations encountered	from	to
WELL LOCATION: sec. <u>5</u> T. <u>18</u> N. R. <u>9</u> E. <u>2</u> miles <u>W</u> of <u>Stewart</u> (distance) (direction) (nearest town)	<u>Red Clay</u>	<u>0</u>	<u>10</u>
	<u>Black dirt</u>	<u>10</u>	<u>43</u>
	<u>SAND</u>	<u>43</u>	<u>47</u>
	<u>Black dirt</u>	<u>47</u>	<u>168</u>
	<u>Fine Silty Sand</u>	<u>168</u>	<u>176</u>
	<u>Grey Chalk</u>	<u>176</u>	<u>188</u>
	<u>Fine Greenish Sand</u>	<u>188</u>	<u>193</u>
	<u>Black dirt</u>	<u>193</u>	<u>208</u>
	<u>Little Rock</u>	<u>208</u>	<u>208</u>
	<u>Fine Sand</u>	<u>208</u>	<u>216</u>
WELL PURPOSE: (home, irrigation, municipal, industrial)	<u>Blue Chalk</u>	<u>216</u>	<u>231</u>
	<u>Greenish Sand</u>	<u>231</u>	<u>275</u>

- WELL COMPLETION DATA:
- (1) diameter (inches) 2
 - (2) total depth (feet) 275
 - (3) static water level (feet) 58 below above top of ground.
 - (4) casing Galv. 204
(material) (depth)
 - 2 if telescope see back.
(size)
 - (5) screen open
(length) (depth to top)
 - (size) (material)
 - (6) pump 3 AIR 25
(HP) (yield gpm)
 - Elec
(type power)
 - (7) electric log NO
(yes or no)
 - (organization running log)
 - (8) how well bottom plugged open


CODED

DRILLERS REMARKS:

JUN 2 1972

If well telescopes please sketch and show depths.

GROUND LEVEL

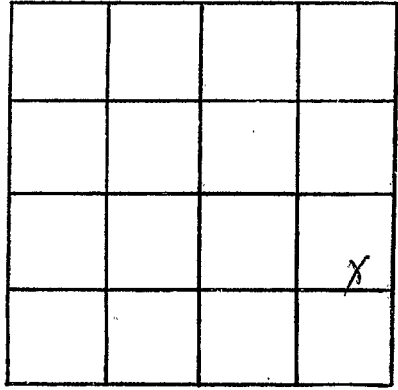

SECTION 5

Please indicate well location X.

ADDITIONAL INFORMATION

A series of horizontal lines for writing additional information.

If more than one screen, show locations of each on sketch.