

**MONTGOMERY**  
 L. S.  
 4-12-73

MISSISSIPPI  
 BOARD OF WATER COMMISSIONERS  
 416 North State Street  
 Jackson, Mississippi 39201

**CODED**

WATER WELL DRILLERS LOG

4-12 1973 Thomas & Son Montgomery  
 date well completed firm name county well located

LANDOWNER: E. H. Fordren  
Stewart, Miss.  
 (mailing address)

WELL LOCATION:  
 sec. 4 T. 18 S. R. 9  
1 miles W of Stewart  
 (distance) (direction) (nearest town)

WELL PURPOSE:  
 home,  irrigation,  municipal,  industrial

- WELL COMPLETION DATA:
- (1) diameter (inches) 2
  - (2) total depth (feet) 515
  - (3) static water level (feet) 22  below above top of ground.
  - (4) casing Galv. 294  
 (material) (depth)
  - 2 if telescope see back.  
 (size)
  - (5) screen open  
 (length) (depth to top)
  - (size) (material)
  - (6) pump 2 10  
 (HP) (yield gpm)
  - elec.  
 (type power)
  - (7) electric log no  
 (yes or no)
  - (organization running log)
  - (8) how well bottom plugged open

description of formations encountered	from	to
Red dirt	0	17
Grey Chalk	17	27
Little Rock	27	
Grey Chalk	27	58
Sand	58	68
Rock 3"	68	
Grey & blue Chalk	68	124
Lignite	124	126
Chalk	126	210
Fine silt	210	229
Rock 3"	229	
Grey Chalk	229	280
Mostly Grey Chalk	280	515
Little str. Fine Sand		


**CODED**

DRILLERS REMARKS:

JUN 11 1973

If well telescopes please sketch and show depths.

GROUND LEVEL

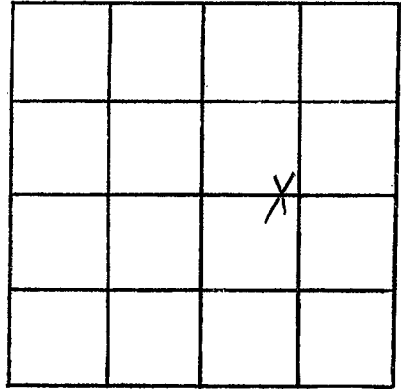

SECTION 4

Please indicate well location X.

ADDITIONAL INFORMATION

If more than one screen,  
show locations of each on sketch.