

MONTGOMERY

L 10

11-73

MISSISSIPPI BOARD OF WATER COMMISSIONERS
416 North State Street
Jackson, Mississippi 39201

WATER WELL DRILLERS LOG

Nov 1973
date well completed

Thomas
firm name

Monte
county well located

LANDOWNER: Glen Mason
Kilmichael, Miss.

(mailing address)

WELL LOCATION:

sec. 7 T 19 N R 8 E
3 1/2 miles E of Kilmichael
(distance) (direction) (nearest town)

WELL PURPOSE:

(home, irrigation, municipal, industrial)

WELL COMPLETION DATA:

- (1) diameter (inches) 2
- (2) total depth (feet) 401
- (3) static water level (feet) 6 ^{below} top of ground.
- (4) casing Galv. 252
(material) (depth)
2 (size) If telescope see back.
- (5) screen Open
(length) (depth to top)
(size) (material)
- (6) pump 1 12
(HP) (yield gpm)
ele.
(type power)
- (7) electric log no
(yes or no)
(organization running log)
- (8) how well bottom plugged open

description of formations encountered

from to

Red Clay	0	10
peck	10	11
Chalky Clay	11	16
Black dirt	16	22
Blue Chalk	22	27
stks coarse sand	27	100
Soft Grey Chalk	100	163
Hard slate	163	169
Grey Chalk	169	184
Chalk + fine silt	184	195
Black dirt	195	252
Black dirt w/ stks sand	252	302
Hard dirt	302	337
Greenish sand	337	401

CODED


DRILLERS REMARKS:

NOV 16 1973

NOV 16 1973

If well telescopes please sketch and show depths.

GROUND LEVEL

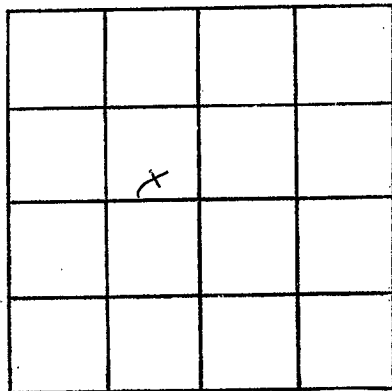

SECTION 2

Please indicate well location X.

ADDITIONAL INFORMATION

If more than one screen, show locations of each on sketch.