

APR-30-2008 08:40A FROM:

TD:16013600535

P:13/15

State Well Report

Part I - Driller's Log

Mississippi Department of Environmental Quality
Office of Land and Water Resources
P.O. Box 10631
Jackson, MS 39289-0631
(601)961-5210
(601)354-6938 (fax)

For Office Use Only:

Aquifer:
Well #: L16
L. S. Elevation: 378
L-log #:

County: Montgomery
Permit #:
Driller: RALPH H waterwell
Date drilling completed: 4-24-08

State Law requires that this report be prepared by the license holder responsible for the work and filed with the Department at the above address within 30 days of completion of drilling of the well or borehole.

Information on Well Owner (Landowner if borehole is not for a water well)
Well or Borehole Location
Latitude: 33° 27' 35" Longitude: 89° 25' 56"
Method of Lat/Long (circle one): Conventional Survey, USGS quad, Hand-held GPS, Survey-grade GPS
NE 1/4 NW 1/4 Sec 2 Twn T18N Rng 9E
Distance 1/2 Miles Direction N of Nearest Town Stewart - 82 Hwy
Well / Borehole Data
Date drilling started: 4-21 Date drilling completed: 4-24 Hole depth: 710 Hole diameter: 6 1/4
Location of the source of any surface water used for drilling: water system
Method of dosing and volume of Chlorine used in drilling and development:
Logs run (circle all applicable): No log run Electric Gamma Ray Density Sonic Neutron Other:
Name of organization running log(s): MS GEO. Survey
Purpose of borehole (check one): Water Well Geotechnical/Geological Investigation Ground Source Heat Pump
Seismic Survey Other (describe) Test hole
If drilling is not related to water well construction, skip the remainder of this block
Purpose of Well (check one): Home Industrial Public Supply Irrigation Fish Culture Other:
If a flowing well, method of flow regulation: Valve Other (describe)
Static Water Level: feet above or below (circle one) land surface Date measured:
Method of Measurement (circle one) steel tape electric tape air line other:
Well depth: Well grouted to a depth of feet Type of grout (circle one): Neat Cement Bentonite Mix
Casing length: feet Casing diameter: inches Type of casing:
Screen length: feet Screen diameter: inches Type of screen:
Screen slot size: inches Setting depth: From feet to feet
Type of completion (circle all applicable): Gravel packed Underreamed Telescoped Open hole Natural Development
Other (describe):
Top of lap pipe or reduction in casing: feet If telescoped or more than one screen, describe on next page

Form: OLWR-SWR-1A

Well plugged & abandoned
4/24/08

RECEIVED
APR 30 2008
BY: OLWR

# Montgomery Co

APR-30-2008 08:41A FROM:

TO:16013600535


P:14/15

Ltb

The sketch below only required for water wells

Description of formations encountered must be provided for all wells and boreholes, unless specifically exempted by regulations


If well tele-screens, show depths on sketch

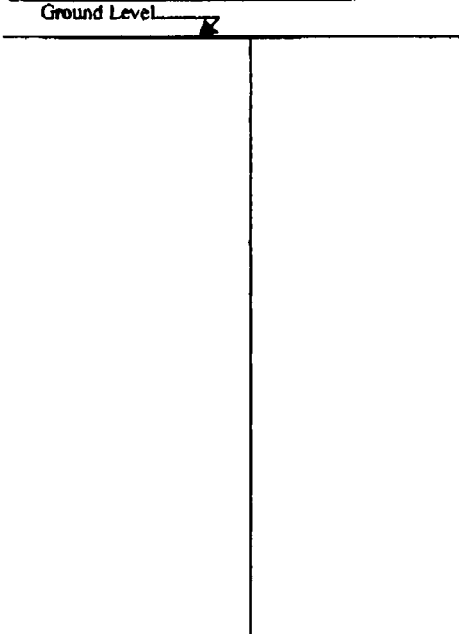

Description of Formations Encountered	From (depth)	To (depth)
Sand	Ground Level	130
Clay/shale	130	710
Rock	710	733

If more than one screen, show location of each on sketch

Sketch the property layout and include the following: 1) the well location; 2) any permanent structures on the property that may aid in locating the well; 3) any roads, power lines, or other items that may aid in locating the property and the well; 4) a north arrow.

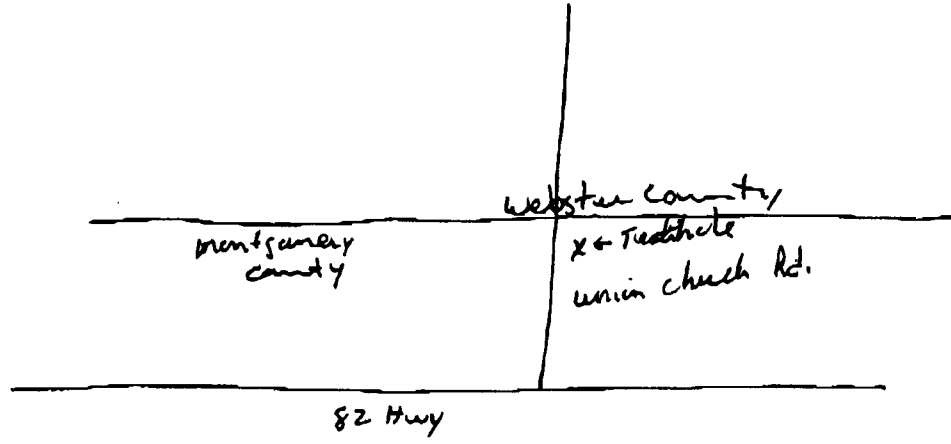

Landowner Name: \_\_\_\_\_

Form: OLWR-SWR-1A

I certify that the well/borehole was drilled, constructed, and completed in accordance with all applicable requirements of the Mississippi Department of Environmental Quality and the Mississippi Department of Health regulations, if applicable, and state laws.

Robert Ruff

4-29-08

Robert Ruff

Print Name of Responsible Licensee and License No.

Date

Signature of Licensee

RECEIVED  
APR 30 2008  
BY: OLWR