

MONTGOMERY

L

2000

MISSISSIPPI
 BOARD OF WATER COMMISSIONERS
 416 North State Street
 Jackson, Mississippi 39201

WATER WELL DRILLERS LOG

Nov. 1978
date well completed

Thomson
firm name

Montgomery

Montgomery
county well located

LANDOWNER: T. N. Prewitt

Stewart, Miss.

(mailing address)

WELL LOCATION:

sec. 5 T. 18 N R. 8 E
 S W
 3 miles S W of Tomblin
 (distance) (direction) (nearest town)

WELL PURPOSE:

(home, irrigation, municipal, industrial)

WELL COMPLETION DATA:

- (1) diameter (inches) 2
- (2) total depth (feet) 178
- (3) static water level (feet) 39 (below above top of ground)
- (4) casing (material) pc (depth) 100
 2 (size) if telescope see back.
- (5) screen (length) open (depth to top)
 (size) (material)
- (6) pump (HP) 1 (yield gpm) 10
 elec- (type power)
- (7) electric log (yes or no) No
- (organization running log)
- (8) how well bottom plugged open

description of formations encountered

from to

description of formations encountered	from	to
Dirt	0	20
Stks lignited Chalk	20	60
Silt & Chalk	60	95
Black Dirt	95	103
Green Sand M Rock & Chalk	103	178


DRILLERS REMARKS:

RECEIVED
JAN 3 1978

MISS. BD. OF WATER COMMISSIONERS

If well telescopes please sketch and show depths.

GROUND LEVEL

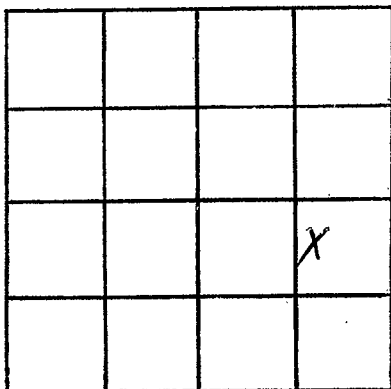

SECTION 5

Please indicate well location X.

ADDITIONAL INFORMATION

If more than one screen, show locations of each on sketch.