

Montgomery
M. I
11-66

MISSISSIPPI
BOARD OF WATER COMMISSIONERS
416 North State Street
Jackson, Mississippi 39201

CODED

WATER WELL DRILLERS LOG

11-25 date well completed 1966 Delta Drilling Co firm name Montgomery county well located

LANDOWNER: Poplar Creek Water Assoc.

| description of formations encountered | from | to |
|---------------------------------------|------|-----|
| | Clay | 0 |
| Sand | 22 | 62 |
| Clay w/ rocks | 62 | 284 |
| Shale | 284 | 320 |
| Sand | 320 | 365 |
| Clay | 365 | 409 |
| Shale | 409 | 504 |
| Clay | 504 | 544 |
| Shale w/ rocks | 544 | 562 |
| Clay | 562 | 582 |
| Sand | 582 | 622 |
| Clay | 622 | 788 |
| Sand | 788 | 826 |
| Shale | 826 | 869 |
| Clay | 869 | 912 |
| Sand | 912 | 952 |

Kilmichael, Miss
(mailing address)


WELL LOCATION:
sec. 10 T 17 N R 7 E
miles at of Poplar Creek
(distance) (direction) (nearest town)

WELL PURPOSE: municipal
(home, irrigation, municipal, industrial)

WELL COMPLETION DATA:

- (1) diameter (inches) 6
- (2) total depth (feet) 1002
- (3) static water level (feet) 90 below top of ground.
- (4) casing BK Steel, 932,
(material) (depth)
6x4x2 1/2 if telescope see back.
(size)
- (5) screen 20', 932
(length) (depth to top)
2 1/2, stainless
(size) (material)
- (6) pump 10 (HP) (yield gpm)
Elec Submersible
(type power)
- (7) electric log Yes
(yes or no)
Miss Geophysical
(organization running log)
- (8) how well bottom plugged 50'
tail pipe

CODED

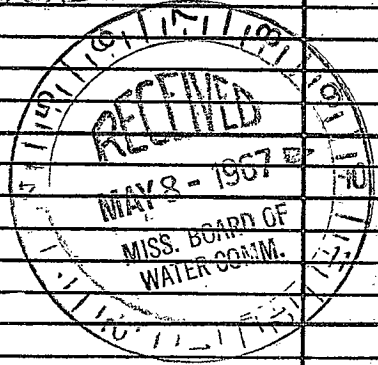

DRILLERS REMARKS:
Robert Weathers

If well telescopes please sketch and show depths.

GROUND LEVEL

6"
252'


4"
350'

2 1/2"
330'

20'
2 1/2" sc.

50'
2 1/2"
Tail pipe

If more than one screen, show locations of each on sketch.

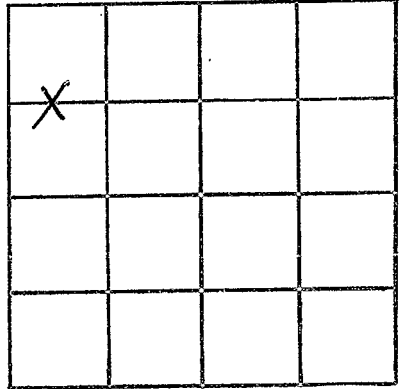

SECTION 10

Please indicate well location X.

ADDITIONAL INFORMATION

Note: 20' of 2 1/2" pipe lapped in 4"

Bottom end of well 50' Tail pipe

Well set at 95°