


WATER WELL DRILLERS LOG

M4  
4-15-63

Date: 4-15, 1963, Driller: Smith & Presley County Montgomery  
 (Name) Palmer tree

CODED

(1) Owner of Land: <u>Mrs. Nancy Palmer tree</u> (Name) <u>Mrs. N.W. Palmer tree</u> (Address)	Description & Color of Materials Sand, Clay, Red Clay, Shell, etc.	Thick- ness Feet	Depth Feet
(2) Location: <u>Sw 1/4 SW 1/4, Sec. 16 T17R7</u> <u>10</u> miles <u>S</u> of <u>Kilmichel</u> (distance) (direction) (Nearest Town)	<u>Yellow sand</u> <u>sand rock</u> <u>about three in.</u>	<u>10</u>	<u>10</u>
(3) Topography: <u>Hilly</u> (Hilly) (Flat) (Level)	<u>yellow sand</u> <u>yellow clay</u> <u>Mixture of</u>	<u>30</u>	<u>40</u>
(4) Purpose of Well: <u>Domestic</u> (Domestic Irrigation Municipal, Industrial, Other)	<u>11 11</u> <u>11 11</u> <u>thin layer of</u> <u>white clay thin</u> <u>rock</u>	<u>23</u> <u>17</u> <u>6</u> <u>21</u>	<u>63</u> <u>80</u>
Information upon completion of well:			
(1) Diameter <u>7</u> inches.	<u>blue clay</u> <u>sand with blue</u> <u>clay mixture</u>	<u>6</u> <u>22</u>	<u>86</u> <u>108</u>
(2) Total Depth <u>190</u> feet.	<u>red shale sand</u> <u>mixture</u>	<u>10</u>	<u>118</u>
(3) Water Level <u>100</u> feet below top of ground.	<u>blue rock</u> <u>blue clay</u>	<u>4"</u> <u>22</u>	<u>140</u>
(4) Cased to <u>186</u> , Size <u>2</u>	<u>hard rock</u> about <u>8"</u> <u>sand</u>	<u>2</u>	<u>142</u>
(5) Screen: Size <u>1 1/4</u> , Length <u>6'</u>	<u>Rock series</u> <u>with a little bit more</u>		
(6) Were any formations sealed against pollution?  _____ yes, _____ no.			
If YES depth of formation _____			
Why _____			
Drillers Remarks: _____			
			<u>40</u> Well No.

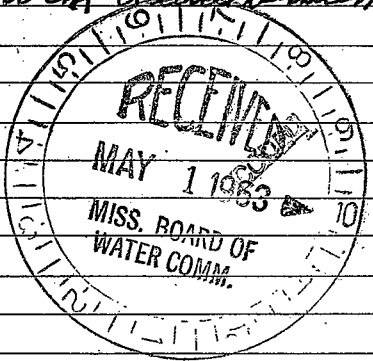

(Use Back Side)

