

Montgomery
 M5
 8-23-68

MISSISSIPPI
 BOARD OF WATER COMMISSIONERS
 416 North State Street
 Jackson, Mississippi 39201

CODED

WATER WELL DRILLERS LOG

Montgomery

8-23 1968 date well completed
 Thomas & Son firm name
 county well located

LANDOWNER: Mrs. N. Palmer

description of formations encountered	from	to
Red Clay	0	20
Dry Sand	20	30
Hard Black Dirt	30	36
Stk's Sand	36	120
Black Dirt		
Hard Black Dirt	120	155
Fine Sand w/ Stk's	155	168
Black Dirt		
Real Course Sand	168	187


Kilmichael, Miss.
 (mailing address)

WELL LOCATION:
 28 sec. 17 T 17 N R 2 E
 S W
 9 miles S of Kilmichael
 (distance) (direction) (nearest town)

WELL PURPOSE:
 (home) Irrigation, municipal, industrial


- WELL COMPLETION DATA:
- diameter (inches) 2
 - total depth (feet) 189
 - static water level (feet) 123 below above top of ground.
 - casing P.V.C. 183
 (material) (depth)
2" if telescope see back.
 (size)
 - screen 6, 183
 (length) (depth to top)
1/4" slot Stainless
 (size) (material)
 - pump 1 5
 (HP) (yield gpm)
Elec.
 (type power)
 - electric log No.
 (yes or no)
 - (organization running log)
 - how well bottom plugged

DRILLERS REMARKS:

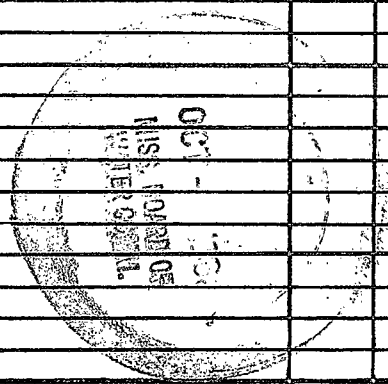

If well telescopes please sketch and show depths.

GROUND LEVEL

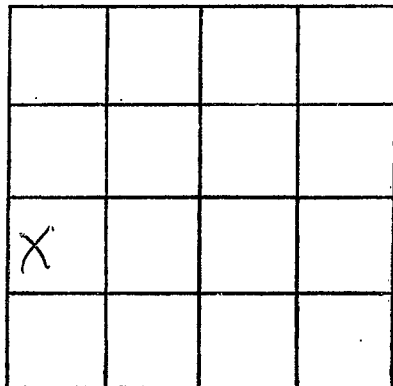

28?

SECTION 27

Please indicate well location X.

ADDITIONAL INFORMATION

If more than one screen,
show locations of each on sketch.