

Montgomery  
M 9

MISSISSIPPI  
BOARD OF WATER COMMISSIONERS  
416 North State Street  
Jackson, Mississippi 39201

**CODED**

112-1-79  
Elog 42

WATER WELL DRILLERS LOG

Jack W. McDaniel Sew Montgomery  
date well completed 1979 firm name county well located

LANDOWNER:

O.D. McElroy  
Kilmichael  
(mailing address)

description of formations encountered

Pipe Clay & rock  
Sand

from to  
30

WELL LOCATION:

sec. 14 T. M N S R. 7 E W  
3 1/4 miles E Paplar Creek  
(distance) (direction) (nearest town)

Mud

34

Sand

41

**CODED**

WELL PURPOSE:

Home  
(home, irrigation, municipal, industrial)

Mud & fine sand  
Narrow streaks

85

WELL COMPLETION DATA:

- (1) diameter (inches) 2 1/2"
- (2) total depth (feet) 240
- (3) static water level (feet) 49 below above top of ground.
- (4) casing PVC, 215,  
(material) (depth)  
4 If telescope see back.  
(size)
- (5) screen 20', 215  
(length) (depth to top)  
(size) PVC (material)
- (6) pump 1/2, 10  
(HP) (yield gpm)  
Elec  
(type power)
- (7) electric log Yes  
(yes or no)  
Miss Geo Survey  
(organization running log)
- (8) how well bottom plugged cap

Mostly mud

185

Sand (Real fine)  
but produces good

242

drilled to 567

Mud rocks

Narrow streaks

Sand (fine & muddy)  
mostly

DEPT. OF NATURAL RESOURCES  
BUREAU OF LAND & WATER RESOURCES

JAN 11 1980


RECEIVED

DRILLERS REMARKS:

Section 14  
30.2 M East of Highway 407  
from Paplar Creek when South  
1/4 Mile

If well telescopes please sketch and show depths.

GROUND LEVEL

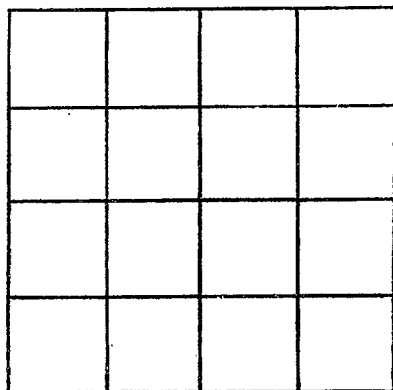

SECTION \_\_\_\_\_

Please indicate well location X.

ADDITIONAL INFORMATION

If more than one screen, show locations of each on sketch.