

MISSISSIPPI DEPARTMENT OF NATURAL RESOURCES

Bureau of Land and Water Resources

Southport Mall

P.O. Box 10631

CODED

Jackson, Mississippi 39209

WATER WELL DRILLERS LOG

Montgomery
M 12

12 November 1986 Herndon Well & Supply, Inc. Montgomery
date well completed firm name county well located

LANDOWNER: Poplar Creek Water Assoc. Rt. 2, Box 63	description of formations encountered	from	to
Kilmichael, MS 39747 (mailing address)	Red & White Sand&Chaulk	0	28
	Blue Sand	28	58
	Blue Clay	58	163
WELL LOCATION:	Streaked Sand & Clay	163	181
sec. 10 T. 17 N. R. 7 E	Rock		181
6 miles South of Kilmichael	Blue Clay	181	207
(distance) (direction) (nearest town)	Blue Sand & Clay	207	233
WELL PURPOSE: Municipal	Rock		233
(home, irrigation, municipal, industrial)	Blue Clay	233	241
WELL COMPLETION DATA:	Rock	241	241
(1) diameter (inches) 10 x 6"	Blue Sandy Clay	241	314
(2) total depth (feet) 952'	Sand	314	353
(3) static water level (feet) 98.77 below top of ground.	Blue Clay	353	636
(4) casing Steel, 905' (material) (depth)	Rock		636
10" if telescope see back. (size)	Blue Clay	636	890
(5) screen 51', 901 (length) (depth to top)	Streaked Sand & Clay	890	910
6" SS Ribbed (size) (material)	Sand	910	950
(6) pump 20, 162 (HP) (yield gpm)	Clay	950	982
Electric (type power)			
(7) electric log yes (yes or no)			
Herndon Well (organization running log)			
(8) how well bottom plugged 6" BW			
DRILLERS REMARKS:			

CODED



RECEIVED

FEB 12 1997

Department of Natural Resources
Bureau of Land & Water Resources

If well telescopes please sketch and show depths.

GROUND LEVEL

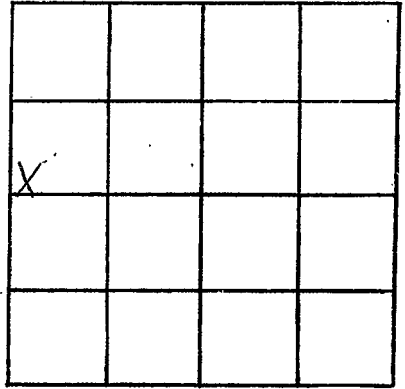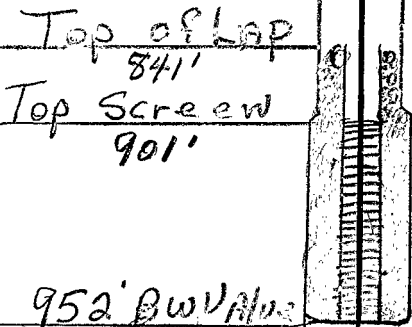

SECTION 10

Please indicate well location X.

ADDITIONAL INFORMATION

If more than one screen, show locations of each on sketch.