

MONTGOMERY
 M 2000
 4-9-76

MISSISSIPPI
 BOARD OF WATER COMMISSIONERS
 416 North State Street
 Jackson, Mississippi 39201

WATER WELL DRILLERS LOG

4-9-76 date well completed Thomas & Son firm name Montgomery county well located

LANDOWNER: Bethany Church
WINONA, Miss.
 (mailing address)

description of formations encountered	from	to
Red SAND	0	25
CHALK & SAND	25	33
CHALK	33	63
Red SAND (Dry)	63	95
BLACK Dirt	95	106
SK " " & SAND	106	111
SLATE Rock	111	115
Grey CHALK	115	123
Redish SAND	123	134

WELL LOCATION:
 sec. 21 T. 17 N. R. 7 E
2 1/2 miles S of Poplar Creek
 (distance) (direction) (nearest town)

WELL PURPOSE: Church
 (home, irrigation, municipal, industrial)

WELL COMPLETION DATA:

(1) diameter (inches) 2

(2) total depth (feet) 134

(3) static water level (feet) 90 below above top of ground.

(4) casing pc 124
 (material) (depth)

2 If telescope see back.
 (size)

(5) screen 10 124
 (length) (depth to top)

2" slot pc
 (size) (material)

(6) pump 1 6
 (HP) (yield gpm)

elec.
 (type power)

(7) electric log NO
 (yes or no)

(organization running log)

(8) how well bottom plugged part


DRILLERS REMARKS:

MAY 12 1976

MISS. DEPT. OF WATER COMMISSIONERS

If well telescopes please sketch and show depths.

GROUND LEVEL

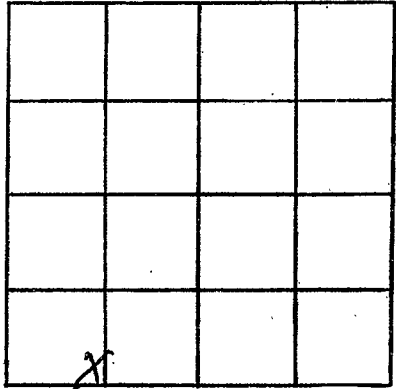

SECTION 21

Please indicate well location X.

ADDITIONAL INFORMATION

If more than one screen, show locations of each on sketch.