

MISSISSIPPI DEPARTMENT OF NATURAL RESOURCES
Bureau of Land and Water Resources
 Southport Mall
 P.O. Box 10631
 Jackson, Mississippi 39209
WATER WELL DRILLERS LOG

Montgomery
 M 2001

9/21
 date well completed

1984 Thomas & Son
 firm name

Montgomery
 county well located

LANDOWNER: *Arthur Hunting Club*

description of formations encountered

from to

<i>Red Dirt</i>	0	6
<i>Red Sand</i>	6	14
<i>Grey Chalk</i>	10	24
<i>Grey Sand</i>	24	38
<i>White C. Sand</i>	38	78

Praine Creek MS
 (mailing address)

WELL LOCATION:

sec. 14 T. 17 N. R. 6 E.
S W
5 miles West of Dunn Creek
 (distance) (direction) (nearest town)

WELL PURPOSE:

(home) irrigation, municipal, industrial

WELL COMPLETION DATA:

- (1) diameter (inches) 2"
- (2) total depth (feet) 78'
- (3) static water level (feet) 18' below above top of ground.
- (4) casing PVC 78'
 (material) (depth)
2" If telescope see back.
 (size)
- (5) screen 10' 68'
 (length) (depth to top)
2" PVC
 (size) (material)
- (6) pump 1 10
 (HP) (yield gpm)
Electric
 (type power)
- (7) electric log NO
 (yes or no)
 (organization running log)
- (8) how well bottom plugged Standard

DEPT. OF NATURAL RESOURCES
 BUREAU OF LAND & WATER RESOURCES


SEP 26 1984

RECEIVED

DRILLERS REMARKS:

If well telescopes please sketch and show depths.

GROUND LEVEL

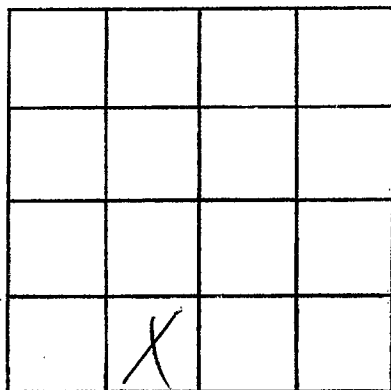

SECTION _____

Please indicate well location X.

ADDITIONAL INFORMATION

If more than one screen, show locations of each on sketch.