

MISSISSIPPI DEPARTMENT OF NATURAL RESOURCES

Bureau of Land and Water Resources

Southport Mall

P.O. Box 10631

Jackson, Mississippi 39209

WATER WELL DRILLERS LOG

Montgomery
M 2003

10-11
date well completed

1984 *Thomas & Son*
firm name

Montgomery
Montgomery
county well located

LANDOWNER: *Mrs Alvin Pickett*

description of formations encountered

from to

RT
Kelvinchil Miss
(mailing address)

<i>Red Sand</i>	<i>0</i>	<i>14</i>
<i>Yellow Sand</i>	<i>14</i>	<i>28</i>
<i>Red Sand</i>	<i>28</i>	<i>50</i>
<i>White Fine Sand</i>	<i>50</i>	<i>76</i>
<i>Gray Chalk</i>	<i>76</i>	<i>84</i>
<i>White Coarse Sand</i>	<i>84</i>	<i>163</i>

WELL LOCATION:

sec. *16* T. *17* N. R. *6* E. S. *W*
2 miles *NE* of *Apalachicola*
(distance) (direction) (nearest town)

Deep 163

WELL PURPOSE:

(home, irrigation, municipal, industrial)

WELL COMPLETION DATA:

- (1) diameter (inches) *4"*
- (2) total depth (feet) *163'*
- (3) static water level (feet) *100'* below above top of ground.
- (4) casing *PVC*, *163'*
(material) (depth)
4"
(size) if telescope see back.
- (5) screen *10'*, *153'*
(length) (depth to top)
4", *PVC*
(size) (material)
- (6) pump *1/2*, *10*
(HP) (yield gpm)
Electric
(type power)
- (7) electric log *NO*
(yes or no)

(organization running log)

(8) how well bottom plugged *Screen*

DEPT. OF NATURAL RESOURCES
BUREAU OF LAND & WATER RESOURCES


OCT 26 1984

RECEIVED

DRILLERS REMARKS:

If well telescopes please sketch and show depths.

GROUND LEVEL

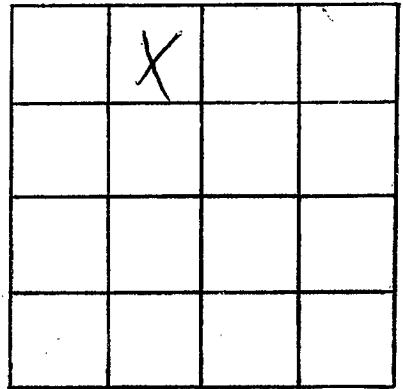

SECTION _____

Please indicate well location X.

ADDITIONAL INFORMATION

If more than one screen, show locations of each on sketch.