

MISSISSIPPI DEPARTMENT OF NATURAL RESOURCES

Bureau of Land and Water Resources

Southport Mall

P.O. Box 10631

Jackson, Mississippi 39209

WATER WELL DRILLERS LOG

MONTGOMERY
M 2003
3-20-85

3-20 1985
date well completed

Thomas & son
firm name

Montgomery
county well located


LANDOWNER: James Rosemond
Pt 2
Kl. Michael Miss
(mailing address)

description of formations encountered	from	to
Red Sand	0	22
Yellow sand	22	48
Gray chalk	48	82
Gray sand	82	102

WELL LOCATION:
sec. 3 T. 17 N. R. 7 E
S W
1 miles N of Indian Creek
(distance) (direction) (nearest town)

WELL PURPOSE:
(home) Irrigation, municipal, industrial

- WELL COMPLETION DATA:
- (1) diameter (inches) 2"
 - (2) total depth (feet) 100'
 - (3) static water level (feet) 18 (below) above top of ground.
 - (4) casing PVC 100' (material) (depth)
2" (size) if telescope see back.
 - (5) screen 10' 90' (length) (depth to top)
2" PVC (size) (material)
 - (6) pump 1 8 (HP) (yield gpm)
Electric (type power)
 - (7) electric log NO (yes or no)
(organization running log)
 - (8) how well bottom plugged Screen

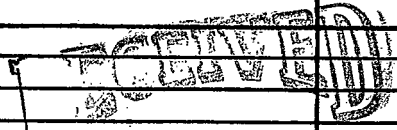


MAR 25 1985

DRILLERS REMARKS:

Department of Natural Resources
Bureau of Land & Water Resources

If well telescopes please
sketch and show depths.

GROUND LEVEL

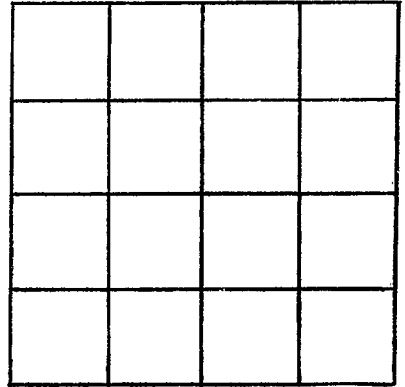

SECTION _____

Please indicate well location X.

ADDITIONAL INFORMATION

If more than one screen,
show locations of each on sketch.