

MISSISSIPPI DEPARTMENT OF NATURAL RESOURCES

Bureau of Land and Water Resources

Southport Mall

P.O. Box 10631

Jackson, Mississippi 39209

WATER WELL DRILLERS LOG

MONTGOMERY  
M 2004  
2-15-85

2-15 1985 date well completed  
Thomas Tson firm name  
Montgomery county well located

LANDOWNER: Tom Chastain

description of formations encountered

from to

Rt 2  
Kelmuchil Miss  
(mailing address)

Red Sand	0	4
Clay Chalk	4	12
Red Sand	12	30
White Sand Chalk	30	46
White Coarse Sand	46	103

WELL LOCATION:

sec. 6 T. 17 N. R. 2 E.  
3 miles NW of Jackson  
(distance) (direction) (nearest town)

WELL PURPOSE:

(home, irrigation, municipal, industrial)

WELL COMPLETION DATA:

- (1) diameter (inches) 2"
- (2) total depth (feet) 103'
- (3) static water level (feet) 28' below top of ground
- (4) casing PVC 103' (material) (depth)  
2" (size) if telescope see back.
- (5) screen 10' 93' (length) (depth to top)  
2" (size) PVC (material)
- (6) pump 1 6 (HP) (yield gpm)  
Electric (type power)
- (7) electric log NO (yes or no)  
(organization running log)
- (8) how well bottom plugged Screen


RECEIVED  
MAR 25 1985

DRILLERS REMARKS:

Department of Natural Resources  
Bureau of Land & Water Resources

If well telescopes please  
sketch and show depths.

GROUND LEVEL

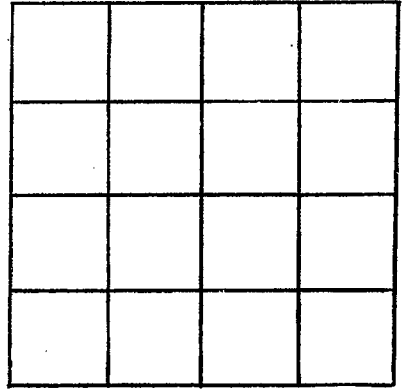

SECTION \_\_\_\_\_

Please indicate well location X.

ADDITIONAL INFORMATION

If more than one screen,  
show locations of each on sketch.