

MISSISSIPPI DEPARTMENT OF NATURAL RESOURCES

Bureau of Land and Water Resources

COUNTY WELL LOCATED Montgomery	
WELL NUMBER 2 N 2	CODED
DATE WELL COMPLETED 09/15/88	

PERMIT NUMBER 8172
NAME OF DRILLING FIRM Herndon Well & Supply
Shannon, MS 38868

P.O. Box 10631
Jackson, Mississippi 39209
WATER WELL DRILLERS LOG

NAME & MAILING ADDRESS OF LANDOWNER French Camp Water Association			
Rt. 1, Box 126			
French Camp, MS 39745			
WELL LOCATION: SEC TOWNSHIP RANGE 8 17 N 8 E			
DISTANCE DIRECTION NEAREST TOWN 5 Miles West of French Camp			
OTHER LANDMARK			
WELL PURPOSE: Home, Irrigation, Municipal, Industrial, Fish Pond, etc. Municipal			

PUMP DATA		
PUMP TYPE (Circle One): hp 30 Submersible Turbine Jet Flowing Well, Other (Describe)		
POWER TYPE (Circle One): Electric Fractor, Diesel, Gasoline, Butane, Other (Describe)		
Pump Capacity (GPM) 340	No. of Stages 6	Setting Depth 202 FT.
PUMP TEST		
Well yielded 340 GPM with a drawdown of 45.37 ft. after 24 hours of pumping		

WELL DATA		
Well Depth 715'11"	Casing Diameter (In.) 10"	Casing Length (Ft.) 667'
Type of Casing Steel	Hole Depth 903'	Depth to Static Water Level 103.59
TYPE OF COMPLETION: (Circle One or More): Gravel Packed , Underreamed, Telescoped, Natural Development, Open Hole, Other (Describe)		
Top of Lap Pipe or Reduction in Casing 601'3" FEET		
IF TELESCOPED OR MORE THAN ONE SCREEN: USE BACK PAGE		

LOG DATA	
TYPE OF LOG RUN (Circle One): No Log Run, Electric , Gamma Ray, Density, Sonic, Neutron, Other (Describe)	
Name of Organization Running Log Herndon Well & Supply, Inc.	

GEOLOGIC DATA (Office Use Only)			
Surface Elev.	Geologic Unit	Unit Thickness	Depth to Top
Subs. SWL	Date SEP 19 1988	Analysis	Aquifer Test


SCREEN DATA		
Diameter - Inches 6"	Length - Feet 50'11"	Slot Size - Inches .020
Screen Type SS Ribbed		Depth to Bottom - Feet 715'11"

Driller's Remarks Department of Natural Resources Bureau of Land & Water Resources
667
716 156


DESCRIPTION OF FORMATIONS ENCOUNTERED	FROM	TO	FORMATIONS (Continued)	FROM	TO
Red Clay	0	10	Tight Sand	510	590
Sand & Lignite	10	35	Clay, Lignite, Sand	590	680
Blue Clay	35	85	Sand	680	720
Rock	85	86	Clay & Sand Streaks	720	903
Blue Clay	86	126			
Rock	126	127½			
Blue Clay	127½	170			
Sand	170	268			
Sandy Clay	268	352			
Sandy Clay/Lignite	352	510			
IF MORE SPACE IS NEEDED, USE BACK					

If well telescopes please sketch and show depths.

GROUND LEVEL

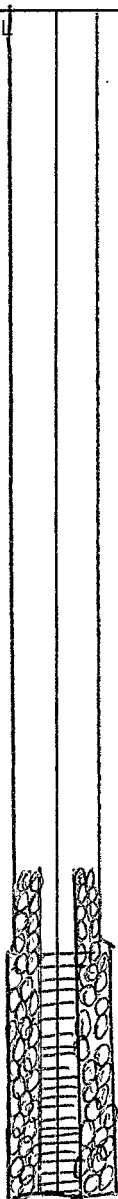

If more than one screen,
show location of each on sketch.

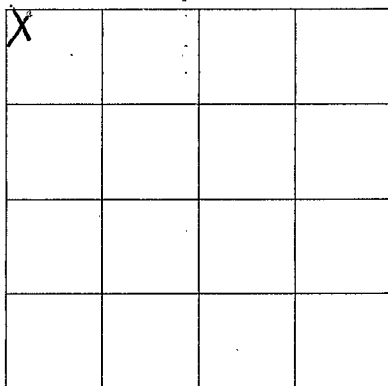

SECTION 8

Please indicate well location X.

ADDITIONAL INFORMATION

Lined area for providing additional information.