

NE SHOBA

B

A

MISSISSIPPI BOARD OF WATER COMMISSIONERS 416 North State Street Jackson, Mississippi 39201

WATER WELL DRILLERS LOG

MAY 28 1976 date well completed

Thomas & Son firm name

Neshoba county well located

LANDOWNER: Kenneth E. Thridgell

description of formations encountered

from to

Phila. Miss.

Red Clay

0 6

CHALK

6 14

BLACK DIRT

12 26

Blue Chalk

26 102

Green Sand

102 104

Hard Black Dirt

104 112

Five Green Sand

112 114

Blue Chalk

114 144

Green Sand

144 189

(mailing address)

WELL LOCATION:

sec 25 T 12 N R 11 E S W (6) miles NW of Phila. (distance) (direction) (nearest town)

WELL PURPOSE: Fish Pond (home, irrigation, municipal, industrial)

WELL COMPLETION DATA:

- (1) diameter (inches) 4"
(2) total depth (feet) 189
(3) static water level (feet) 42 below top of ground
(4) casing (material) PVC (depth) 110
(5) screen (size) 4" (length) open (depth to top)
(6) pump (HP) 1 (yield gpm) 30 (type power) Elec
(7) electric log NO
(8) how well bottom plugged open


DRILLERS REMARKS:

RECEIVED MAY 17 1976

MISS. BD. OF WATER COMMISSIONERS

If well telescopes please sketch and show depths.

GROUND LEVEL

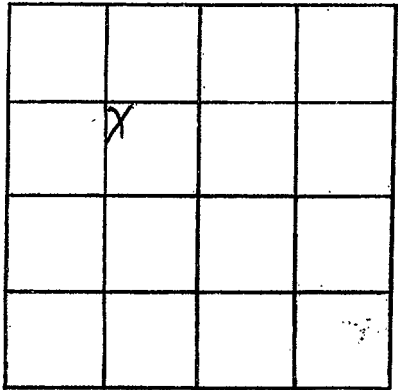

SECTION 30

Please indicate well location X.

ADDITIONAL INFORMATION

If more than one screen, show locations of each on sketch.