

A / S 13T  
4-10-63

WATER WELL DRILLERS LOG

CODED

Date: 4-10, 19 63, Driller: Hearon Drilling County Neshoba  
(Name)

(1) Owner of Land: FG Mc Murry  
(Name)

R6 Cottage  
(Address)

(2) Location: 1/4, E 1/4, Sec. 31 T. 14 R. 10

         miles          of           
(distance) (direction) (Nearest Town)

(3) Topography:           
(Hilly) (Flat) (Level)

(4) Purpose of Well: Domestic  
(Domestic Irrigation  
Municipal, Industrial, Other)

Description & Color of Materials Sand, Clay, Red Clay, Shell, etc.	Thick- ness Feet	Depth Feet
Clay	10	10
Sand & Clay	40	50
Stone & Rock	7	57
Hard Rock	2	60
Rock & Hard Shell	55	115
Hard Shell	25	140
Layers of Sand	10	150
Gray Sand	8	158

Information upon completion of well:

(1) Diameter 2 inches.

(2) Total Depth 158 feet.

(3) Water Level 78 feet below top of ground.

(4) Cased to 153, Size 2"

(5) Screen: Size 2 1/2", Length 55


(6) Were any formations sealed against pollution?  
         yes,  no.

If YES depth of formation         

Why         

Drillers Remarks:         

CODED

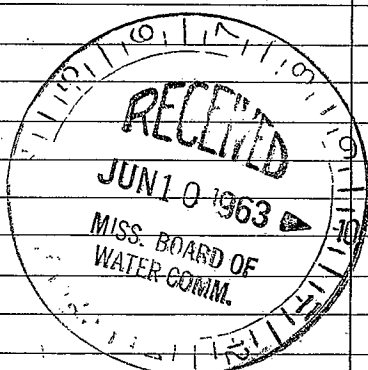

(Use Back Side)

Well No.

