

NESHOBAMA

WATER WELL DRILLERS LOG

CODED

E 304

A2

Date: 7-2, 1961, Driller: _____

County: _____

2-3-61

(Name)

(1) Owner of Land:	Description & Color of Materials Sand, Clay, Red-Clay, Shell, etc.	Thick- ness Feet	Depth Feet
(Name)			50
(Address)			70
(2) Location: _____ 1/4, _____ 3/4, Sec. <u>12</u> T. <u>10</u> R.			
_____ miles (distance)	(direction)	(Nearest Town)	
(3) Topography: _____			
(Hilly)	(Flat)	(Level)	
(4) Purpose of Well: _____			
(Domestic Irrigation Municipal, Industrial, Other)			

Information upon completion of well:


- (1) Diameter 2 inches.
- (2) Total Depth 70 feet.
- (3) Water Level 50 feet below top of ground.
- (4) Cased to 65, Size 2 in
- (5) Screen: Size 1/2 in, Length 5 ft
- (6) Were any formations sealed against pollution?
_____ yes, no.

If YES depth of formation _____

Why _____

Drillers Remarks: _____

CODED

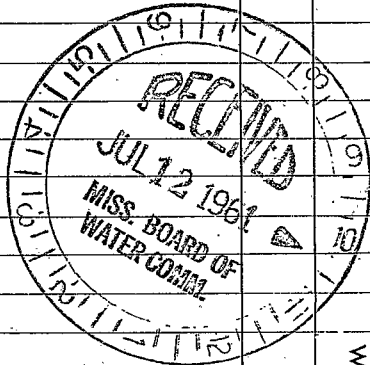

(Use Back Side)

Well No. _____

