

CODED
CODED
CODED

Neshoba
A3
1-14-69

MISSISSIPPI
BOARD OF WATER COMMISSIONERS
416 North State Street
Jackson, Mississippi 39201

WATER WELL DRILLERS LOG

Neshoba
Attke

1-14 1969
date well completed

Thomas & Son
firm name

county well located

LANDOWNER: Mr. H. Blocker
Edingburg, Miss.
(mailing address)

description of formations encountered	from	to
<u>Red CLAY</u>	<u>0</u>	<u>25</u>
<u>SAND</u>	<u>25</u>	<u>41</u>
<u>CHALK AT BOTTOM</u>		

WELL LOCATION:
sec. 30 T. 12 N. R. 10 E
S W
5 miles NE of Edingburg
(distance) (direction) (nearest town)

WELL PURPOSE:
(Home, irrigation, municipal, industrial)

WELL COMPLETION DATA:

- (1) diameter (inches) 2
- (2) total depth (feet) 41
- (3) static water level (feet) 25 ^{below} _{above} top of ground.
- (4) casing Galv. 36
(material) (depth)
2" if telescope see back.
(size)
- (5) screen 5 36
(length) (depth to top)
8 slot BRASS
(size) (material)
- (6) pump 1/2 4
(HP) (yield gpm)
Elec
(type power)
- (7) electric log NO
(yes or no)

(organization running log)

(8) how well bottom plugged

DRILLERS REMARKS:


CODED

JAN 15 1969

MISS. Bd. of
WATER COMMISSIONERS

If well telescopes please sketch and show depths.

GROUND LEVEL

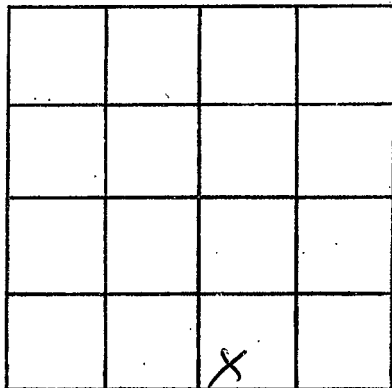

SECTION 30

Please indicate well location X.

ADDITIONAL INFORMATION

If more than one screen, show locations of each on sketch.