

CODED

MISSISSIPPI  
BOARD OF WATER COMMISSIONERS  
416 North State Street  
Jackson, Mississippi 39201

WATER WELL DRILLERS LOG

Neshoba  
A 5  
8-5-69

8-5 19 69 Ogletree Drilling Neshoba  
date well completed firm name county well located

LANDOWNER:  
H. O. Dallis  
Rt. 8 Phila-Miss  
(mailing address)

description of formations encountered	from	to
<u>Red Clay</u>	<u>0</u>	<u>10</u>
<u>Red sand</u>	<u>10</u>	<u>15</u>
<u>Blue Clay</u>	<u>15</u>	<u>300</u>
<u>White sand</u>	<u>300</u>	<u>325</u>

WELL LOCATION:  
sec. 12 T 12 N R 10 E  
S W  
9 miles North of Phila-Miss  
(distance) (direction) (nearest town)

WELL PURPOSE: Home  
(home, irrigation, municipal, industrial)

WELL COMPLETION DATA:

(1) diameter (inches) 2"

(2) total depth (feet) 325

(3) static water level (feet) 40 (below/above top of ground)

(4) casing Galv., 3/5" (material), (depth)

         if telescope see back.  
(size)

(5) screen 10', 325-315  
(length) (depth to top)

1/4", stainless steel  
(size) (material)

(6) pump 3/4 6  
(HP) (yield gpm)


R.P.A.  
(type power)

(7) electric log No.  
(yes or no)

          
(organization running log)


(8) how well bottom plugged Painted

DRILLERS REMARKS:

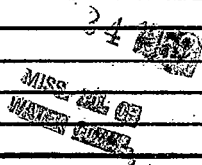

If well telescopes please sketch and show depths.

GROUND LEVEL

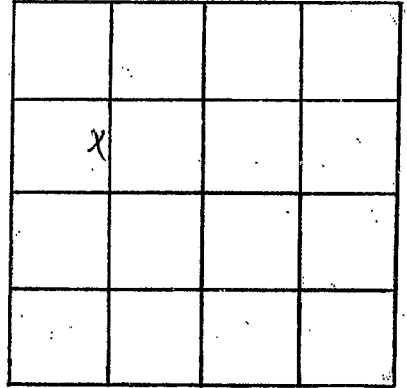

SECTION 12

Please indicate well location X.

ADDITIONAL INFORMATION

If more than one screen, show locations of each on sketch.