

CODED

MISSISSIPPI
BOARD OF WATER COMMISSIONERS
416 North State Street
Jackson, Mississippi 39201

WATER WELL DRILLERS LOG

Neshoba
A 6
8-6-69

8-6 1969 Ogletree Drilling Co Neshoba
date well completed firm name county well located

LANDOWNER:

Clyde Kilgorn
Rt. 2 Phila. Miss
(mailing address)

description of formations encountered

from to

Red Clay 0 10
Red sand 10 15
Blue Chalk 15 300
White sand 300 325

WELL LOCATION:

sec 12 T 12 S R 10 E
9 miles North of Phila. Miss
(distance) (direction) (nearest town)

WELL PURPOSE: Home use
(home, irrigation, municipal, industrial)

WELL COMPLETION DATA:

- (1) diameter (inches) 2"
- (2) total depth (feet) 325
- (3) static water level (feet) 40 below above top of ground.
- (4) casing Galv., 315,
(material) (depth)
if telescope see back.
(size)
- (5) screen 10', 325-315
(length) (depth to top)
1/4", Stainless Steel
(size) (material)
- (6) pump 3/4, 6
(HP) (yield gpm)
R.E.A.
(type power)
- (7) electric log _____
(yes or no)
(organization running log)
- (8) how well bottom plugged Painted


DRILLERS REMARKS:

24

MISS. BO. OF
WATER COMMISSIONERS

If well telescopes please sketch and show depths.

GROUND LEVEL

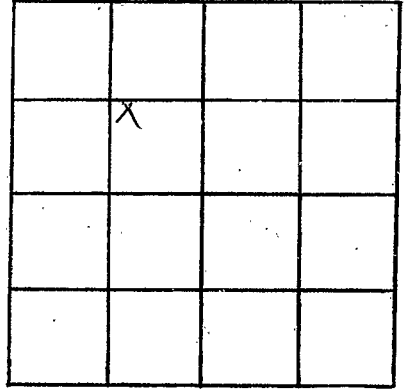

SECTION 22

Please indicate well location X.

ADDITIONAL INFORMATION

If more than one screen,
show locations of each on sketch.