

NESHOPA
A 7
8-26-69

MISSISSIPPI
 BOARD OF WATER COMMISSIONERS
 416 North State Street
 Jackson, Mississippi 39201

CODED

WATER WELL DRILLERS LOG

8-26-69 date well completed 1969 firm name county well located

LANDOWNER:
 Louis N. O'D
 W. R. Co. Thos. & Sons
 (mailing address)

description of formations encountered	from	to
red clay	0	20
red sand	20	28
blue shale	28	29
white sand	29	30

WELL LOCATION:
 sec. 30 T. 12 N. R. 10 E.
 9 miles N.W. of Philadelphia
 (distance) (direction) (nearest town)

WELL PURPOSE: water
 (home, irrigation, municipal, industrial)


- WELL COMPLETION DATA:**
- (1) diameter (inches) 2"
 - (2) total depth (feet) 293
 - (3) static water level (feet) 60 below above top of ground.
 - (4) casing Galv. 2 1/2" (material) 273 (depth)
 (size) If telescope see back.
 - (5) screen 10' (length) 283-273 (depth to top)
1 1/2" (size) stainless steel (material)
 - (6) pump 1 (HP) 0 (yield gpm)
P.P.A. (type power)
 - (7) electric log NO (yes or no)
 (organization running log)
 - (8) how well bottom plugged None

DRILLERS REMARKS:

NOV 17 1969
 MISSISSIPPI BOARD OF WATER COMMISSIONERS

If well telescopes please
sketch and show depths.

GROUND LEVEL

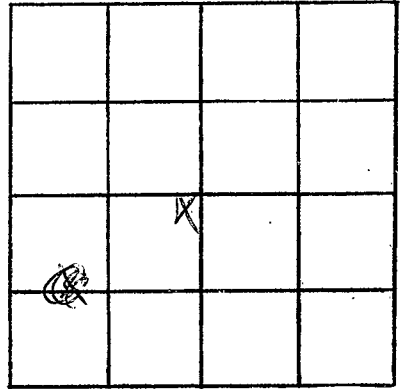

SECTION 30

Please indicate well location X.

ADDITIONAL INFORMATION

If more than one screen,
show locations of each on sketch.