

Meshoba
A 8
4-21-70

MISSISSIPPI
 BOARD OF WATER COMMISSIONERS
 416 North State Street
 Jackson, Mississippi 39201

CODED

WATER WELL DRILLERS LOG

4-21 1970 Drillers Co. Meshoba
 date well completed firm name county well located

LANDOWNER:

H. A. Blunt
Box 8
 (mailing address)

description of formations encountered

from to

(Red Clay) 0 15
(Red sand) 15 40
(White sand) 40 49

WELL LOCATION:

sec. 3 T. 12 N. R. 10 E.
S W
12 miles N. W. of Phil.
 (distance) (direction) (nearest town)

WELL PURPOSE:

Home use
 (home, irrigation, municipal, industrial)

WELL COMPLETION DATA:

- (1) diameter (inches) 2
- (2) total depth (feet) 48
- (3) static water level (feet) 30 below above top of ground.
- (4) casing Steel, 42
 (material) (depth)
 (size) if telescope see back.
- (5) screen 5, 48-42
 (length) (depth to top)
1/2, 20 mesh
 (size) (material)
- (6) pump 1HP 6.3
 (HP) (yield gpm)
Clear
 (type power)
- (7) electric log NO
 (yes or no)
 (organization running log)
- (8) how well bottom plugged Partial

CODED


MAY 1 1970

DRILLERS REMARKS:

MISS. BD. OF
 WATER COMM.

If well telescopes please sketch and show depths.

GROUND LEVEL

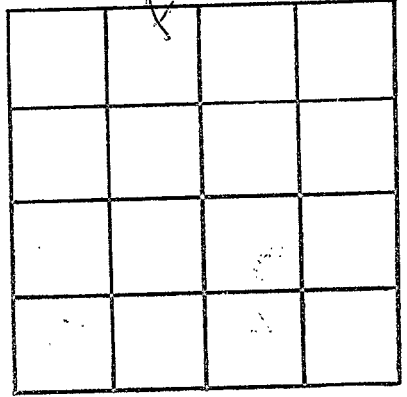

SECTION 3

Please indicate well location X.

ADDITIONAL INFORMATION

If more than one screen, show locations of each on sketch.