

NESHOBA

A09

9-18-70

MISSISSIPPI BOARD OF WATER COMMISSIONERS
416 North State Street
Jackson, Mississippi 39201

CODED

WATER WELL DRILLERS LOG

9-18 1970
date well completed

Thomas & Son
firm name

Neshoba
county well located

LANDOWNER: Mr. Edward Sanders
NoxiDATA, Miss.

(mailing address)

WELL LOCATION:

sec. 7 T. 12 N R. 10 E
11 miles NW of Philadelphia
(distance) (direction) (nearest town)

WELL PURPOSE:

(home, irrigation, municipal, industrial)

WELL COMPLETION DATA:

- (1) diameter (inches) 2
- (2) total depth (feet) 112
- (3) static water level (feet) 80 ^{below}/_{above} top of ground.
- (4) casing PVC 106
(material) (depth)
2 if telescope see back.
(size)
- (5) screen 6 106
(length) (depth to top)
1 1/4 slot S.S.
(size) (material)
- (6) pump 1 5
(HP) (yield gpm)
ELC
(type power)
- (7) electric log No
(yes or no)

(organization running log)

(8) how well bottom plugged

description of formations encountered	from	to
Red clay	0	19
Rock	19	21
Red sand	21	50
Chalk & little sand	50	104
Course sand	104	112

CODED


OCT 14 1970

DRILLERS REMARKS:

MISS. BD. OF
WATER COMM.

If well telescopes please sketch and show depths.

GROUND LEVEL

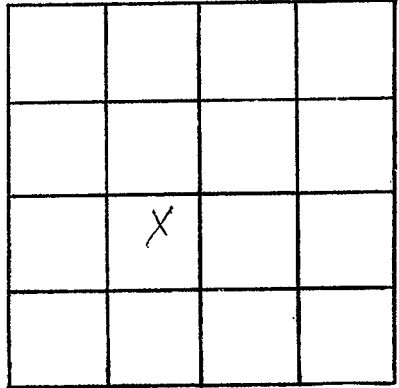

SECTION 7

Please indicate well location X.

ADDITIONAL INFORMATION

If more than one screen,
show locations of each on sketch.