

Neshoba  
 A 10  
 3-20-69

MISSISSIPPI  
 BOARD OF WATER COMMISSIONERS  
 416 North State Street  
 Jackson, Mississippi 39201

**CODED**  
 CODED

WATER WELL DRILLERS LOG

3-20 19 69 Thomas & Son Neshoba  
 date well completed firm name county well located

LANDOWNER: T. O. Tucker  
Edingburg, M. S.  
 (mailing address)

description of formations encountered	from	to
Red Clay	0	15
Dry Sand	15	18
Rock	18	18 1/2
Water Sand	18 1/2	21
Slate Rock & Black Dirt	21	100
5'ks. of Sand & Black Dirt	100	126
Chalky Sand	126	140
Course White Sand	140	152

WELL LOCATION:  
 sec. 30 T. 12N S. R. 10E  
5 miles NE of Edingburg  
 (distance) (direction) (nearest town)

WELL PURPOSE:  
 (home, irrigation, municipal, industrial)

- WELL COMPLETION DATA:
- (1) diameter (inches) 2
  - (2) total depth (feet) 152
  - (3) static water level (feet) 68 <sup>below</sup>/<sub>above</sub> top of ground.
  - (4) casing Galv. 147  
 (material) (depth)  
2 if telescope see back.  
 (size)
  - (5) screen 5 147  
 (length) (depth to top)  
1 1/4 slot stainless.  
 (size) (material)
  - (6) pump 1 6  
 (HP) (yield gpm)  
Elec  
 (type power)
  - (7) electric log NO  
 (yes or no)
  - (8) how well bottom plugged \_\_\_\_\_  
 (organization running log)


DRILLERS REMARKS:

**CODED**

APR 10 1969  
 MISS. BD. OF WATER COMMISSIONERS

If well telescopes please sketch and show depths.

GROUND LEVEL

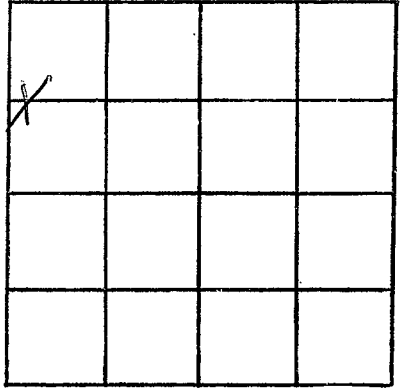

SECTION 30

Please indicate well location X.

ADDITIONAL INFORMATION

If more than one screen,  
show locations of each on sketch.