

NEHOBA

A 13

2-23-74

MISSISSIPPI BOARD OF WATER COMMISSIONERS
416 North State Street
Jackson, Mississippi 39201

CODED

WATER WELL DRILLERS LOG

Feb-23 1974 Beck Smith Neshoba
date well completed firm name county well located


LANDOWNER:	description of formations encountered	from	to
Ardie Vance	red clay	0	25
Phila. Miss (mailing address)	blue chalk	25	120
	sand	120	16

WELL LOCATION:
sec. 5 T. 12 N. R. 10 E. S. 1 W.
1.2 miles North of Phila.
(distance) (direction) (nearest town)

WELL PURPOSE: home
(home, irrigation, municipal, industrial)

- WELL COMPLETION DATA:
- (1) diameter (inches) 2"
 - (2) total depth (feet) 160
 - (3) static water level (feet) 20 below above top of ground.
 - (4) casing galv. 105 (material) (depth)
(size) if telescope see back.
 - (5) screen (length) (depth to top)
(size) (material)
 - (6) pump LHP 6 (HP) (yield gpm)
elec (type power)
 - (7) electric log (yes or no)
(organization running log)
 - (8) how well bottom plugged open
well

CODED

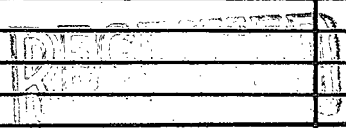


MAR 18 1974

DRILLERS REMARKS:

MISS. BD. OF WATER COMMISSIONERS

If well telescopes please sketch and show depths.

GROUND LEVEL

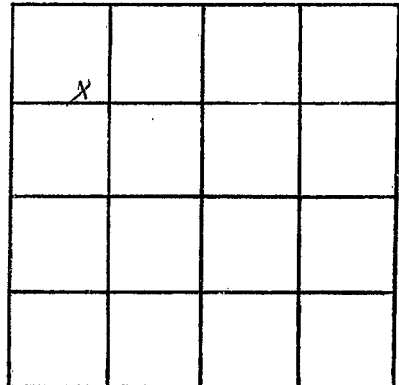

SECTION _____

Please indicate well location X.

ADDITIONAL INFORMATION

Lined area for additional information.

If more than one screen, show locations of each on sketch.