

NESHABA

A14

3-8-74

MISSISSIPPI BOARD OF WATER COMMISSIONERS CODED 416 North State Street Jackson, Mississippi 39201

WATER WELL DRILLERS LOG

Mar. 8 19 date well completed

Beck Smith firm name

Neshoba county well located

LANDOWNER:

J. H. Nance

Phila Miss (mailing address)

description of formations encountered

red clay blue chalk gray sand

from	to
0	85
85	100
100	119

WELL LOCATION:

sec 5 T 12 S R 10 W

9 miles N of Phila (distance) (direction) (nearest town)

WELL PURPOSE: home (home, irrigation, municipal, industrial)

WELL COMPLETION DATA:

- (1) diameter (inches) 2"
- (2) total depth (feet) 119'
- (3) static water level (feet) 65' below top of ground.

(4) casing galv. 114' (material) (depth) If telescope see back. (size)

(5) screen 5' 114' (length) (depth to top) 008 stainless steel (size) (material)

(6) pump 1 HP 6 (HP) (yield gpm) elec (type power)

(7) electric log (yes or no)

(organization running log)


(8) how well bottom plugged back Wash Valve

DRILLERS REMARKS:

MAR 16 1974 MISSISSIPPI BOARD OF WATER COMMISSIONERS

If well telescopes please sketch and show depths.

GROUND LEVEL

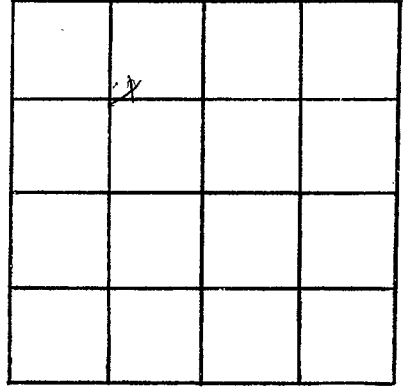

SECTION _____

Please indicate well location X.

ADDITIONAL INFORMATION

If more than one screen,
show locations of each on sketch.