

NEHOBA

A 15

7-16-74

MISSISSIPPI BOARD OF WATER COMMISSIONERS  
416 North State Street  
Jackson, Mississippi 39201

CODED

WATER WELL DRILLERS LOG

F. D. Commons Neshoba

7-16-74 19  
date well completed

firm name

county well located

LANDOWNER: Richard R. Beuk  
Rt 8 Box 101A  
Philadelphia, Miss. 39353  
(mailing address)

description of formations encountered	from	to
Red clay	0	30
50 coarse sand	30	50

WELL LOCATION:

sec. 9 T<sub>12N</sub> S R 10 E W<sub>1</sub>  
13 miles N of Philadelphia  
(distance) (direction) (nearest town)

WELL PURPOSE:

(home) irrigation, municipal, industrial

CODED

WELL COMPLETION DATA:

- (1) diameter (inches) 2"
- (2) total depth (feet) 50
- (3) static water level (feet) 20 below top of ground.
- (4) casing 2" PVC 44' (material) (depth)  
2" (size) if telescope see back.
- (5) screen 2" PVC 44' (length) (depth to top)  
2" PVC 6' (size) (material)
- (6) pump 1/2 (HP) 115 (yield gpm)  
E. Lec. (type power)
- (7) electric log 110 (yes or no)  
Cap. (organization running log)
- (8) how well bottom plugged


JUL 16 1974

MISS. BD. OF WATER COMMISSIONERS

DRILLERS REMARKS:

If well telescopes please sketch and show depths.

GROUND LEVEL

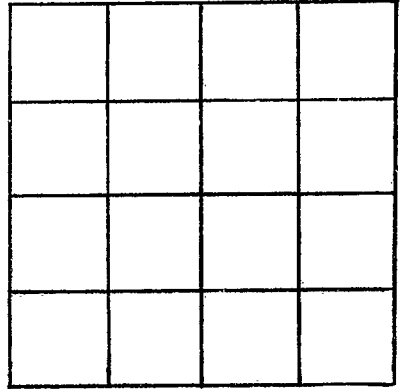

SECTION \_\_\_\_\_

Please indicate well location X.

ADDITIONAL INFORMATION

If more than one screen,  
show locations of each on sketch.