

Neshoba
A 16
10- -80

MISSISSIPPI
BOARD OF WATER COMMISSIONERS
416 North State Street
Jackson, Mississippi 39201

CODED

WATER WELL DRILLERS LOG

date well completed 19 80 firm name Thomas county well located Neshoba

LANDOWNER: M. R. Snow
Edgingburg, MS
(mailing address)

WELL LOCATION:
sec. 32 T. 12 S. R. 10 E
5 miles NE of Edgingburg
(distance) (direction) (nearest town)
10 mi. NW Phila

WELL PURPOSE:
(home, irrigation, municipal, industrial)

- WELL COMPLETION DATA:
- (1) diameter (inches) 4" - 386 FT
 - (2) total depth (feet) 386
 - (3) static water level (feet) 130 ^{below} _{above} top of ground.
 - (4) casing PVC (material) 351 (depth)
4x2 (size) if telescope see back.
 - (5) screen 35 (length) 351 (depth to top)
2" slot PVC (size) (material)
 - (6) pump 3/4 (HP) 15 (yield gpm)
Ebc (type power)
 - (7) electric log No (yes or no)
(organization running log)
 - (8) how well bottom plugged part

description of formations encountered	from	to
Dry SAND	0	78
CHALK	78	92
SLATE ROCK + CHALK	92	115
Dry SAND	115	130
Grey CHALK	130	165
Fine SAND	165	188
STKS F SANDS + CHALK	188	205
Hard Grey CHALK	205	307
Peewee Fine SAND	307	346
90 Gause SAND	346	358
BLACK DIRT	358	362
Fine SAND	362	386

DEPT. OF NATURAL RESOURCES
 BUREAU OF LAND & WATER RESOURCES
 JAN 19 1981
 RECEIVED

DRILLERS REMARKS:


If well telescopes please sketch and show depths.

GROUND LEVEL

4" PVC
TO
180 FT

2" PVC
TO 351'

35'
2" slot
PVC screen

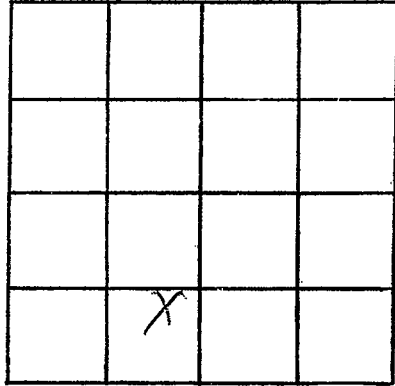

SECTION 32

Please indicate well location X.

ADDITIONAL INFORMATION

If more than one screen,
show locations of each on sketch.