

Neshoba
A 2000
3/76

MISSISSIPPI
BOARD OF WATER COMMISSIONERS
416 North State Street
137 Jackson, Mississippi 39201

WATER WELL DRILLERS LOG


March 1976 date well completed
Thomas & Son firm name
Neshoba county well located

LANDOWNER: <u>White Oak Church</u>	description of formations encountered	from	to
<u>Edingboro, Miss.</u> (mailing address)	<u>Red Clay</u>	0	5
	<u>SAND</u>	5	58
	<u>Blue Chalk</u>	58	82
	<u>Yellow Chalk</u>	82	85
	<u>Course Sand</u>	85	95
WELL LOCATION:			
sec. <u>29</u> T. <u>12</u> N. R. <u>10</u> W.			
<u>11</u> miles <u>NW</u> of <u>Phil.</u>			
(distance) (direction) (nearest town)			
WELL PURPOSE: <u>Church</u>			
(home, irrigation, municipal, industrial)			
WELL COMPLETION DATA:			
(1) diameter (inches) <u>2</u>			
(2) total depth (feet) <u>95</u>			
(3) static water level (feet) <u>70</u> ^{below} _{above} top of ground.			
(4) casing <u>PVC</u> <u>90</u>			
(material) (depth)			
<u>2</u> if telescope see back.			
(size)			
(5) screen: <u>5</u> <u>90</u>			
(length) (depth to top)			
<u>2" 8 slot PVC</u>			
(size) (material)			
(6) pump <u>1</u> <u>6</u>			
(HP) (yield gpm)			
<u>elec.</u>			
(type power)			
(7) electric log <u>No</u>			
(yes or no)			
(organization running log)			
(8) how well bottom plugged <u>fair</u>			
DRILLERS REMARKS:			

REGISTERED
MAY 3 1976

If well telescopes please sketch and show depths.

GROUND LEVEL

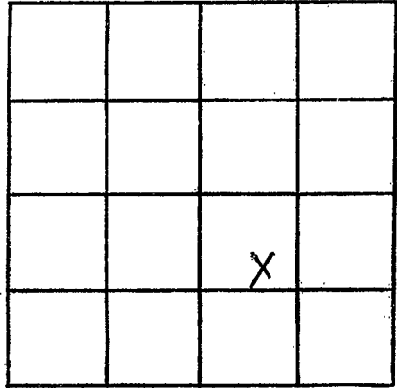

SECTION 29

Please indicate well location X.

ADDITIONAL INFORMATION

If more than one screen,
show locations of each on sketch.