

Neshoba  
A 2001  
4/76

MISSISSIPPI  
 BOARD OF WATER COMMISSIONERS  
 416 North State Street  
 Jackson, Mississippi 39201

WATER WELL DRILLERS LOG

April 1976 The Mas & Son Neshoba  
 date well completed firm name county well located

LANDOWNER: Covert Ferguson  
Edgingburg, Miss  
Philadelphia  
 (mailing address)

description of formations encountered	from	to
Rock & Clay	0	17
SAND	17	22
Soft Rock	22	33
Black Dirt	33	38
5 1/2" Black " + Sand	38	63
" White Chalk & Sand	63	96

WELL LOCATION:  
 sec 28 T 12N R 10E  
11 miles W of Phila  
 (distance) (direction) (nearest town)

WELL PURPOSE:  
 Home, irrigation, municipal, industrial

WELL COMPLETION DATA:

(1) diameter (inches) 2

(2) total depth (feet) 96

(3) static water level (feet) 40 <sup>below</sup> above top of ground.

(4) casing PVC 86  
 (material) (depth)

2 if telescope see back.  
 (size)

(5) screen 10 86  
 (length) (depth to top)

2" PVC 95 ft  
 (size) (material)

(6) pump 1 old pump 5  
 (HP) (yield gpm)

Elec  
 (type power)

(7) electric log No  
 (yes or no)

(organization running log)


(8) how well bottom plugged Sealed

DRILLERS REMARKS:

APR 12 1976

If well telescopes please sketch and show depths.

GROUND LEVEL

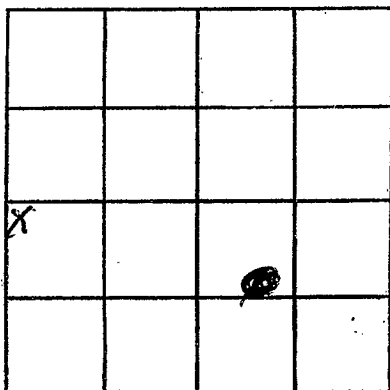

SECTION 28

Please indicate well location X.

ADDITIONAL INFORMATION

If more than one screen, show locations of each on sketch.