

Neshoba
A 2002
10-21-76

MISSISSIPPI
BOARD OF WATER COMMISSIONERS
416 North State Street
137 Jackson, Mississippi 39201

WATER WELL DRILLERS LOG

10-21 date well completed 76 Beck Smith firm name Neshoba county well located

LANDOWNER:	description of formations encountered	from	to
Danny Gray Phila, Miss. (mailing address)			

WELL LOCATION:
20 sec. 5 T 12 N R 10 E
S W
710± miles NW of Phila.
(distance) (direction) (nearest town)

WELL PURPOSE: home
(home, irrigation, municipal, industrial)

- WELL COMPLETION DATA:
- (1) diameter (inches) 2"
 - (2) total depth (feet) 215
 - (3) static water level (feet) 75 ^{below} top of ground.
 - (4) casing galv. 205, 5" (material) (depth) (size) If telescope see back.
 - (5) screen 10', 205 (length) (depth to top) 008, stainless steel (size) (material)
 - (6) pump 1 HP (HP) (yield gpm) Elec. (type power)
 - (7) electric log (yes or no)
- (organization running log)
- (8) how well bottom plugged back Wash water


DRILLERS REMARKS:

RECEIVED

NOV 18 1976

If well telescopes please sketch and show depths.

GROUND LEVEL

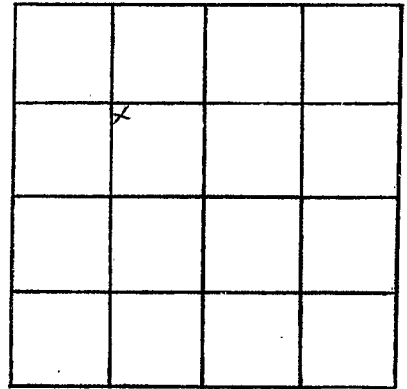

SECTION _____

Please indicate well location X.

ADDITIONAL INFORMATION

If more than one screen,
show locations of each on sketch.