

Neshoba
 A 2004
 12/76

MISSISSIPPI
 BOARD OF WATER COMMISSIONERS
 416 North State Street
 13T Jackson, Mississippi 39201

WATER WELL DRILLERS LOG

Neshoba
 Latta

Dec - 19 76 The Mast Son date well completed firm name county well located

LANDOWNER: Paul Woods Edingburg, Miss. (mailing address)	description of formations encountered	from	to
	fine clay	0	15
	Hard slate rock	15	40
	Dry sand	40	70
	Coarse sand	70	102

WELL LOCATION:
 sec. 33T 13N R 10E
 5 miles NE of Edingburg
 (distance) (direction) (nearest town)

WELL PURPOSE: chickens
 (home, irrigation, municipal, industrial)

- WELL COMPLETION DATA:
- (1) diameter (inches) 2
 - (2) total depth (feet) 102
 - (3) static water level (feet) 70 below top of ground above
 - (4) casing PVC 90 (material) (depth)
 2 (size) If telescope see back.
 - (5) screen 12 90 (length) (depth to top)
 2 80/100 PVC (size) (material)
 - (6) pump 2 10 (HP) (yield gpm)
 Elec. (type power)
 - (7) electric log No (yes or no)

(organization running log)

(8) how well bottom plugged Point


DRILLERS REMARKS:

RECEIVED
 DEC 23 1976

MISS. BD. OF WATER COMMISSIONERS

If well telescopes please sketch and show depths.

GROUND LEVEL

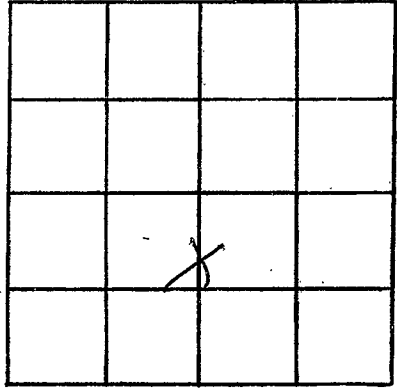

SECTION 33

Please indicate well location X.

ADDITIONAL INFORMATION

If more than one screen,
show locations of each on sketch.