

Neshoba  
A 2005  
11/2/77

MISSISSIPPI  
BOARD OF WATER COMMISSIONERS  
416 North State Street  
Jackson, Mississippi 39201

WATER WELL DRILLERS LOG

11-2 1977 Beck Smiths Well Drilling Neshoba  
date well completed firm name county well located

LANDOWNER:	description of formations encountered	from	to
Hugh Richardson Phila, Miss. (mailing address)			
<b>WELL LOCATION:</b>			
sec <u>5</u> T <u>12</u> <u>N</u> R <u>10</u> <u>E</u>			
<u>15</u> miles <u>NW</u> of <u>Phila</u> (distance) (direction) (nearest town)			
<b>WELL PURPOSE:</b> (home, irrigation, municipal, industrial)			
<b>WELL COMPLETION DATA:</b>			
(1) diameter (inches) <u>2"</u>			
(2) total depth (feet) <u>238'</u>			
(3) static water level (feet) <u>41</u> <u>below</u> top of ground. <u>above</u>			
(4) casing <u>PVC</u> <u>228</u> (material) (depth)			
_____ If telescope see back. (size)			
(5) screen <u>10'</u> <u>228'</u> (length) (depth to top)			
_____ <u>PVC</u> (size) (material)			
(6) pump <u>1 HP</u> <u>8</u> (HP) (yield gpm)			
_____ <u>elec</u> (type power)			
(7) electric log _____ (yes or no)			
_____ (organization running log)			
(8) how well bottom plugged <u>back</u> <u>Wash valve</u>			
DRILLERS REMARKS:			


RECEIVED

JAN 27 1978

MISS. BD. OF WATER COMM

If well telescopes please sketch and show depths.

GROUND LEVEL

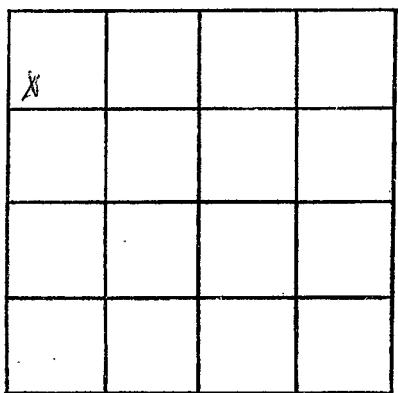

SECTION \_\_\_\_\_

Please indicate well location X.

ADDITIONAL INFORMATION

A series of horizontal lines for entering additional information.

If more than one screen, show locations of each on sketch.