

NE SHOBA

A 2006

4/10/78

MISSISSIPPI BOARD OF WATER COMMISSIONERS 416 North State Street Jackson, Mississippi 39201

WATER WELL DRILLERS LOG

4-11-78 date well completed McDonald & Hill firm name Ne Shoba county well located


Table with columns for LANDOWNER, WELL LOCATION, WELL PURPOSE, WELL COMPLETION DATA, and description of formations encountered. Includes handwritten entries for Elise Henry, Philodaria, and well specifications like 4" diameter, 200' depth, and 68' static water level.

RECEIVED APR 17 1978

MISS. BD. OF WATER COMM

If well telescopes please sketch and show depths.

GROUND LEVEL

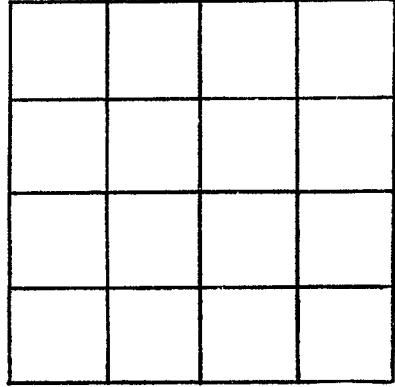

SECTION _____

Please indicate well location X.

ADDITIONAL INFORMATION

If more than one screen, show locations of each on sketch.