

MISSISSIPPI DEPARTMENT OF NATURAL RESOURCES

Bureau of Land and Water Resources

Southport Mall

P.O. Box 10631

Jackson, Mississippi 39209

WATER WELL DRILLERS LOG

Nehoa  
A  
2007

9-1-81 19  
 date well completed

F.D. Comand  
 firm name

NE Shoda  
 county well located

LANDOWNER: Robert Long

description of formations encountered

from

to

Red Clay @ 20  
Shale 20 40  
Sand Clay 40 100

(mailing address)

WELL LOCATION:

sec. 60128 @ 100  
27 miles W of Carthage  
 (distance) (direction) (nearest town)

WELL PURPOSE:

(home) irrigation, municipal, industrial

WELL COMPLETION DATA:

- (1) diameter (inches) 2"
- (2) total depth (feet) 100'
- (3) static water level (feet) 60' below top of ground.
- (4) casing 2" 100'  
 (material) (depth)  
2" if telescope see back.  
 (size)
- (5) screen 2" 100'  
 (length) (depth to top)  
2" x 15" PVC  
 (size) (material)
- (6) pump 1 220  
 (HP) (yield gpm)  
Elec.  
 (type power)
- (7) electric log NO  
Sand Shale  
 (organization running log)

*This is a copy*

DEPT. OF NATURAL RESOURCES  
 BUREAU OF LAND & WATER RESOURCES

JUN 25 1982


RECEIVED

DRILLERS REMARKS:

(8) how well bottom plugged

If well telescopes please  
sketch and show depths.

GROUND LEVEL

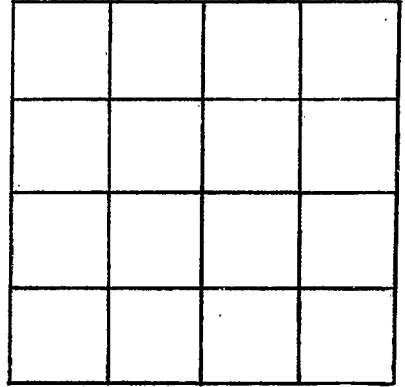

SECTION \_\_\_\_\_

Please indicate well location X.

ADDITIONAL INFORMATION

If more than one screen,  
show locations of each on sketch.