

MISSISSIPPI DEPARTMENT OF NATURAL RESOURCES
 Bureau of Land and Water Resources
 Southport Mall
 P.O. Box 10631
 Jackson, Mississippi 39209
WATER WELL DRILLERS LOG

Neshoba
A-2009

8-11 1983 Thomas & son Neshoba Co
 date well completed firm name county well located

LANDOWNER: <u>Paul Woods</u> <u>Pt 8</u> <u>Carthage Miss</u> (mailing address)	description of formations encountered	from	to
	<u>Red sand</u>	<u>0</u>	<u>18</u>
	<u>Grey hard chalk</u>	<u>18</u>	<u>50</u>
	<u>White sand</u>	<u>30</u>	<u>58</u>
	<u>Grey coarse sand</u>	<u>58</u>	<u>85</u>
WELL LOCATION:			
sec. <u>30</u> T. <u>14N</u> R. <u>10E</u> <u>12S</u> <u>10W</u>			
<u>5</u> miles <u>SE</u> of <u>Deluga</u> (distance) (direction) (nearest town)			
WELL PURPOSE: (home, irrigation, municipal, industrial)			
WELL COMPLETION DATA:			
(1) diameter (inches) <u>2"</u>			
(2) total depth (feet) <u>85'</u>			
(3) static water level (feet) <u>28</u> <u>below</u> above top of ground.			
(4) casing <u>PVC</u> <u>85'</u> (material) (depth)			
<u>2" @ 10'</u> if telescope see back. (size)			
(5) screen <u>10'</u> <u>75'</u> (length) (depth to top)			
<u>2"</u> <u>PVC</u> (size) (material)			
(6) pump <u>1</u> <u>8</u> (HP) (yield gpm)			
<u>Electric</u> (type power)			
(7) electric log <u>No</u> (yes or no)			
<u>(organization running log)</u>			
(8) how well bottom plugged <u>Screen</u>			
DRILLERS REMARKS:			


DEPT. OF NATURAL RESOURCES
 BUREAU OF LAND & WATER RESOURCES

AUG 24 1983

RECEIVED

If well telescopes please sketch and show depths.

GROUND LEVEL

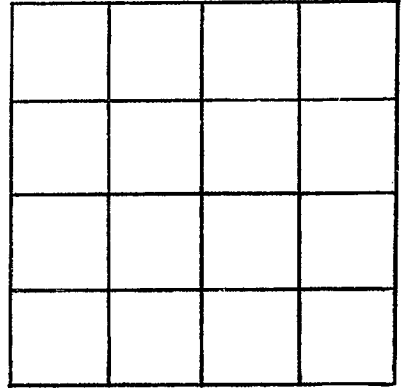

SECTION _____

Please indicate well location X.

ADDITIONAL INFORMATION

If more than one screen, show locations of each on sketch.