

MISSISSIPPI DEPARTMENT OF NATURAL RESOURCES

Bureau of Land and Water Resources

Southport Mall

P.O. Box 10631

Jackson, Mississippi 39209

WATER WELL DRILLERS LOG

WESHUBA
A
2011


12-7-1985 date well completed F.O. Conner firm name WESHUBA county well located

LANDOWNER:	description of formations encountered	from	to
Clinton H. Mason	Red clay	0	30
RH 7 Bay 268	Sand	30	40
PHILADELPHIAMS 29350	Clay	40	60
(mailing address)	Black	60	90
	Sand	90	110
	Bedrock	110	140
	Red sand	140	168

WELL LOCATION:
 sec. 11 @ 12 @ 10 E
 10 miles N of PHILADELPHIA
 (distance) (direction) (nearest town)

WELL PURPOSE:
 (home) Irrigation, municipal, industrial

- WELL COMPLETION DATA:
- (1) diameter (inches) 2"
 - (2) total depth (feet) 168
 - (3) static water level (feet) 68 below above top of ground.
 - (4) casing 2" 168
 (material) (depth)
2" if telescope see back.
 (size)
 - (5) screen 2" P.V.C. 168
 (length) (depth to top)
1/4 x 10, STAINLESS S.F.F.L. 105
 (size) (material)
 - (6) pump 1 220
 (HP) (yield gpm)
Elip.
 (type power)
 - (7) electric log NO
 (yes or no)
point S.F.F.L.
 (organization running log)
 - (8) how well bottom plugged _____

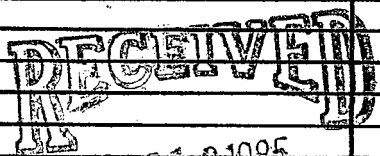


DEC 10 1985

Department of Natural Resources
 Bureau of Land & Water Resources

DRILLERS REMARKS:

If well telescopes please
sketch and show depths.

GROUND LEVEL

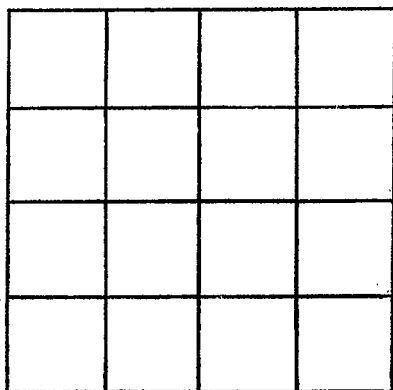

SECTION _____

Please indicate well location X.

ADDITIONAL INFORMATION

If more than one screen,
show locations of each on sketch.