

MISSISSIPPI DEPARTMENT OF NATURAL RESOURCES

Bureau of Land and Water Resources

Southport Mall

P.O. Box 10631


Jackson, Mississippi 39209

WATER WELL DRILLERS LOG

NEHOBA
A202

12-30-1985 19 F. D. Lowery NEHOBA
 date well completed firm name county well located

LANDOWNER:	Description of formations encountered	from	to
<u>Conner Thompson</u> <u>Rt 8, Box 133, PHILADELPHIA</u>	<u>Red clay</u>	<u>0</u>	<u>30</u>
(mailing address)	<u>Sand clays</u>	<u>30</u>	<u>60</u>
WELL LOCATION:	<u>Sand clays</u>	<u>60</u>	<u>85</u>
sec. <u>9</u> <u>13</u> <u>N</u> <u>10</u> <u>E</u>			
<u>12</u> miles <u>N</u> of <u>PHILADELPHIA</u>			
(distance) (direction) (nearest town)			
WELL PURPOSE:			
(home) irrigation, municipal, industrial			
WELL COMPLETION DATA:			
(1) diameter (inches) <u>2"</u>			
(2) total depth (feet) <u>85'</u>			
(3) static water level (feet) <u>40'</u> below top of ground.			
(4) casing <u>2"</u> <u>85'</u>			
(material) (depth)			
<u>2</u> if telescope see back.			
(size)			
(5) screen <u>2"</u> <u>85'</u>			
(length) (depth to top)			
<u>2x10'</u> <u>P.V.C.</u>			
(size) (material)			
(6) pump <u>1</u> <u>220</u>			
(HP) (yield gpm)			
<u>Cole</u>			
(type power)			
(7) electric log <u>NO</u>			
(yes or no)			
<u>Sand Block</u>			
(organization running log)			
(8) how well bottom plugged			

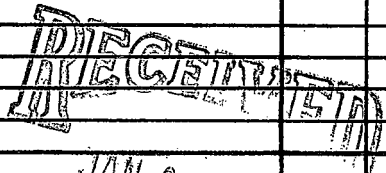


JAN 06 1986

Department
Bureau of

DRILLERS REMARKS:

If well telescopes please
sketch and show depths.

GROUND LEVEL

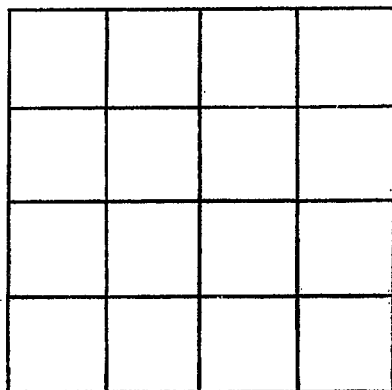

SECTION _____

Please indicate well location X.

ADDITIONAL INFORMATION

If more than one screen,
show locations of each on sketch.