

MISSISSIPPI DEPARTMENT OF NATURAL RESOURCES

Bureau of Land and Water Resources

P.O. Box 10631

Jackson, Mississippi 39209

WATER WELL DRILLERS LOG

COUNTY WELL LOCATED RESHBOA	
WELL NUMBER A 2018	CODED
DATE WELL COMPLETED 10/18/89	

PERMIT NUMBER
NAME OF DRILLING FIRM THOMAS DRILLING
206 GRAHAM ST. CARTHAGE, MISS. 39051

NAME & MAILING ADDRESS OF LANDOWNER Gregthist Thompson		
WELL LOCATION: SEC 21 TOWNSHIP 12 RANGE 10		
DISTANCE 2 Miles S DIRECTION of Alice NEAREST TOWN		
OTHER LANDMARK 1/2 Miles E of Cemetery		
WELL PURPOSE (Home Irrigation, Municipal, Industrial, Fish Pond, etc.)		

PUMP DATA		
PUMP TYPE (Circle One): Submersible, Turbine, Jet Flowing Well, Other (Describe) _____		
POWER TYPE (Circle One): Electric , Tractor, Diesel, Gasoline, Butane, Other (Describe) _____ H/P 2AA		
Pump Capacity (GPM) 8	No. of Stages 3	Setting Depth 120 FT.
PUMP TEST		
Well yielded 8 GPM with a drawdown of 8 ft. after 1 hours of pumping		

WELL DATA		
Well Depth 520	Casing Diameter (In.) 2"	Casing Length (Ft.) 510'
Type of Casing Ppc	Hole Depth 2"	Depth to Static Water Level 90'
TYPE OF COMPLETION: (Circle One or More): Gravel Packed , Underreamed, Telescoped, Natural Development, Open Hole, Other (Describe) _____		
Top of Lap Pipe or Reduction in Casing		
FEET IF TELESCOPED OR MORE THAN ONE SCREEN: USE BACK PAGE		

LOG DATA	
TYPE OF LOG RUN (Circle One): Electric, Gamma Ray, Density, Sonic, Neutron, Other (Describe) No Log Run	
Name of Organization Running Log	

SCREEN DATA		
Diameter - Inches 2"	Length - Feet 10'	Slot Size - Inches .10
Screen Type Dic Wrapped	Depth to Bottom - Feet 520	


GEOLOGIC DATA (Office Use Only)			
Surface Elev.	Geologic Unit	Unit Thickness	Depth to Top
Subs. SWL	Date	Analysis	Aquifer Test
Driller's Remarks			

DESCRIPTION OF FORMATIONS ENCOUNTERED	FROM	TO	FORMATIONS (Continued) FROM TO
Red DIRT	0	10	<div style="font-size: 2em; font-weight: bold; opacity: 0.5;">DRILLER'S SIGNATURE</div> <p style="font-size: 1.5em; font-weight: bold; margin-top: 10px;">OCT 24 1989</p> <p style="font-size: 0.8em; margin-top: 10px;">Department of Natural Resources Bureau of Land & Water Resources</p>
Gray Chalk	10	80	
" SAND	80	130	
" Chalk	130	180	
Blue Chalk	180	240	
Gray & Blue "	240	420	
Gray Chalk	420	470	
Chalk & Sand	470	490	
GRAY Sand	490	520	

IF MORE SPACE IS NEEDED, USE BACK

If well telescopes please sketch and show depths.

GROUND LEVEL

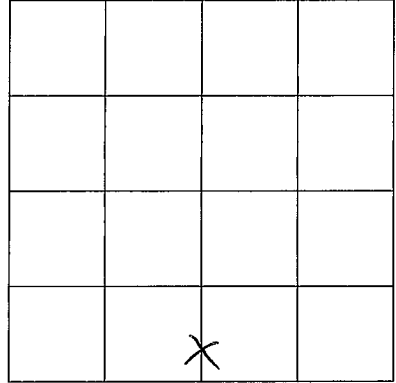

SECTION 21

Please indicate well location X.

ADDITIONAL INFORMATION

If more than one screen, show location of each on sketch.