

**MISSISSIPPI DEPARTMENT OF NATURAL RESOURCES**  
**Bureau of Land and Water Resources**  
 Southport Mall  
 P.O. Box 10631  
 Jackson, Mississippi 39209  
**WATER WELL DRILLERS LOG**

NEADA  
A 2020

11-01-90 19  
 date well completed

Smith's well Drilling  
 firm name

Wichita  
 county well located

LANDOWNER: Bob F. Hodge

description of formations encountered

from to

Red Clay		65
SAND	15	60
BLUE CLAY	60	92
CLAY ROCK	92	140
BLUE CLAY	140	210
CLAY & SAND	210	270

(mailing address)

WELL LOCATION:

sec 26 T 12 N R 10 E  
 S W

11 miles of 11  
 (distance) (direction) (nearest town)

WELL PURPOSE:

(home, irrigation, municipal, industrial)

WELL COMPLETION DATA:

(1) diameter (inches) 4

(2) total depth (feet) 270

(3) static water level (feet) 92 <sup>below</sup> / above top of ground.

(4) casing PVC (material), 180 (depth)

     (size) If telescope see back.

(5) screen      (length) /      (depth to top)

     (size) (material)

(6) pump 1/2 (HP) / 12 (yield gpm)

E (type power)

(7) electric log      (yes or no)

     (organization running log)

(8) how well bottom plugged     

**RECEIVED**


NOV 26 1990

Department of Natural Resources  
 Bureau of Land & Water Resources

DRILLERS REMARKS:

If well telescopes please  
sketch and show depths.

GROUND LEVEL

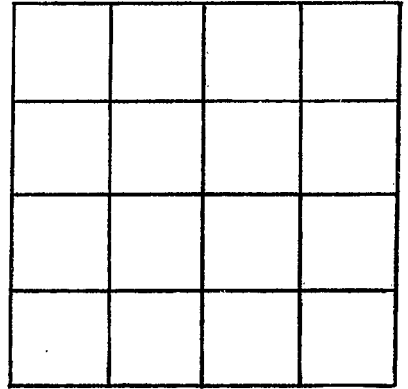

SECTION \_\_\_\_\_

Please indicate well location X.

ADDITIONAL INFORMATION

A series of horizontal lines for recording additional information, starting below the 'ADDITIONAL INFORMATION' header and extending to the bottom of the page.

If more than one screen,  
show locations of each on sketch.