

**MISSISSIPPI DEPARTMENT OF NATURAL RESOURCES**  
**Bureau of Land and Water Resources**  
Southport Mall  
P.O. Box 10631  
Jackson, Mississippi 39209  
**WATER WELL DRILLERS LOG**

N 751004  
A 2021

12-3-79 1985 Smiths Well Drilling 751004  
date well completed firm name county well located

LANDOWNER: Paul Woods  
  
(mailing address)

WELL LOCATION:  
sec 38 T 12 N S R 10 E W  
miles of  
(distance) (direction) (nearest town)

WELL PURPOSE: Farm  
(home, irrigation, municipal, industrial)

- WELL COMPLETION DATA:
- (1) diameter (inches) 4
  - (2) total depth (feet) 165
  - (3) static water level (feet) 10 below/above top of ground.
  - (4) casing (material) 4" (depth) 165  
4" If telescope see back.  
(size)
  - (5) screen (length) 165 (depth to top) 165  
(size) (material)
  - (6) pump (HP) (yield gpm)  
(type power)
  - (7) electric log (yes or no)  
(organization running log)
  - (8) how well bottom plugged plug

DRILLERS REMARKS:


description of formations encountered	from	to
<u>10'</u>	<u>2</u>	<u>11</u>
<u>2-4'</u>	<u>11</u>	<u>15</u>
<u>10-12'</u>	<u>15</u>	<u>25</u>
<u>12-15'</u>	<u>25</u>	<u>35</u>
<u>15-18'</u>	<u>35</u>	<u>45</u>
<u>18-22'</u>	<u>45</u>	<u>55</u>
<u>22-28'</u>	<u>55</u>	<u>65</u>
<u>28-35'</u>	<u>65</u>	<u>75</u>
<u>35-45'</u>	<u>75</u>	<u>85</u>
<u>45-55'</u>	<u>85</u>	<u>95</u>
<u>55-65'</u>	<u>95</u>	<u>105</u>
<u>65-75'</u>	<u>105</u>	<u>115</u>
<u>75-85'</u>	<u>115</u>	<u>125</u>
<u>85-95'</u>	<u>125</u>	<u>135</u>
<u>95-105'</u>	<u>135</u>	<u>145</u>
<u>105-115'</u>	<u>145</u>	<u>155</u>
<u>115-125'</u>	<u>155</u>	<u>165</u>

**RECEIVED**  
NOV 26 1991

Department of Natural Resources  
Bureau of Land and Water Resources

If well telescopes please  
sketch and show depths.

GROUND LEVEL

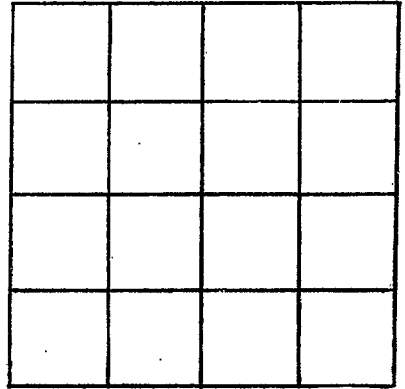

SECTION \_\_\_\_\_

Please indicate well location X.

ADDITIONAL INFORMATION

If more than one screen,  
show locations of each on sketch.