

MISSISSIPPI DEPARTMENT OF NATURAL RESOURCES
 Bureau of Land and Water Resources
 Southport Mall
 P.O. Box 10631
 Jackson, Mississippi 39209
WATER WELL DRILLERS LOG

NEARORA
A 2022

11-12-88 19 1988 Smith well Smith
 date well completed firm name county well located

LANDOWNER: Smith
 (mailing address)

description of formations encountered	from	to
<u>hard rock</u>	<u>10</u>	<u>10</u>
<u>hard rock</u>	<u>10</u>	<u>10</u>
<u>hard rock</u>	<u>10</u>	<u>10</u>

WELL LOCATION:
 sec 28 T 12 N R 10 E
 S W
1 miles west of Smith
 (distance) (direction) (nearest town)

WELL PURPOSE: water
 (home, irrigation, municipal, industrial)

- WELL COMPLETION DATA:
- (1) diameter (inches) 4
 - (2) total depth (feet) 10
 - (3) static water level (feet) 10 below/above top of ground.
 - (4) casing 110 (material), (depth),
 (size) if telescope see back.
 - (5) screen 10 (length), (depth to top)
 (size), (material)
 - (6) pump 1 (HP), (yield gpm)
 (type power)
 - (7) electric log yes or no
 (organization running log)
 - (8) how well bottom plugged 1


DRILLERS REMARKS:

RECEIVED
 NOV 26 1988

Department of Natural Resources
 Bureau of Land & Water Resources

If well telescopes please
sketch and show depths.

GROUND LEVEL

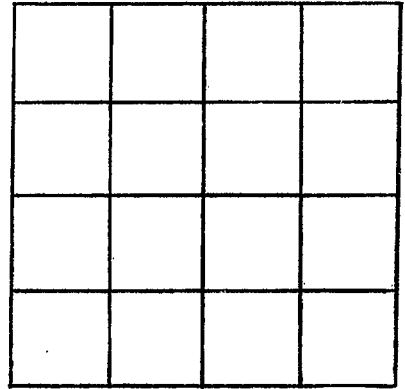

SECTION _____

Please indicate well location X.

ADDITIONAL INFORMATION

If more than one screen,
show locations of each on sketch.