

MISSISSIPPI DEPARTMENT OF NATURAL RESOURCES

Bureau of Land and Water Resources

Southport Mall

P.O. Box 10631

Jackson, Mississippi 39209

WATER WELL DRILLERS LOG

Neshoba  
A  
2006

6-19-1982  
date well completed

J. D. Cowan  
firm name

NEHOBA  
county well located

LANDOWNER: <u>C. M. STUART</u> <u>R. L. &amp; PHILADEL</u> (mailing address)	Description of formations encountered	from	to
	<u>Red clay</u>	<u>0</u>	<u>16</u>
	<u>Calc. Sand</u>	<u>16</u>	<u>42</u>
	<u>Black Sand</u>	<u>42</u>	<u>120</u>
	<u>Thin sand</u>	<u>110</u>	<u>138</u>
	<u>Black clay</u>	<u>130</u>	<u>160</u>
	<u>Thin sand</u>	<u>160</u>	<u>170</u>
	<u>Black dense</u>	<u>170</u>	<u>210</u>
	<u>Brayford green</u>		
		<u>210</u>	<u>250</u>
WELL LOCATION: sec. <u>14012</u> <u>(R) 10</u> <u>13</u> miles <u>N</u> of <u>PHILADEL</u> (distance) (direction) (nearest town)			
WELL PURPOSE: <u>(home)</u> irrigation, municipal, industrial			
WELL COMPLETION DATA: (1) diameter (inches) <u>9 1/2</u> (2) total depth (feet) <u>250'</u> (3) static water level (feet) <u>200</u> below above top of ground. (4) casing <u>9 PVC, 100'</u> (material) (depth) <u>9 1/2"</u> If telescope see back. (size) (5) screen <u>2 1/2"</u> <u>250'</u> (length) (depth to top) (size) (material) (6) pump <u>1</u> <u>110</u> (HP) (yield gpm.) <u>Electric</u> (type power) (7) electric log <u>110</u> (yes or no) <u>one Shell Corp</u> (organization running log) (8) how well bottom plugged _____			
DRILLERS REMARKS:			


DEPT. OF NATURAL RESOURCES  
BUREAU OF LAND & WATER RESOURCES

JUN 21 1982

RECEIVED

If well telescopes please sketch and show depths.

GROUND LEVEL

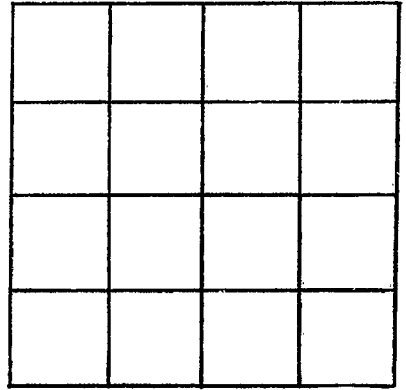

SECTION \_\_\_\_\_

Please indicate well location X.

ADDITIONAL INFORMATION

If more than one screen, show locations of each on sketch.