

3 13T

Neshoba  
B 2  
6-67

MISSISSIPPI CODED  
BOARD OF WATER COMMISSIONERS  
416 North State Street  
Jackson, Mississippi 39201  
WATER WELL DRILLERS LOG

JUNE 27 19 67 OGLETREE DRILLING NESHOBA  
date well completed firm name county well located

LANDOWNER: KENNETH INGRIM

description of formations encountered

from to

RT. 8

|            |     |     |
|------------|-----|-----|
| RED CLAY   | 0   | 10  |
| RED SAND   | 10  | 40  |
| BLUE CHALK | 40  | 210 |
| GRAY CHALK | 210 | 360 |
| GRAY SAND  | 360 | 428 |

PHILADELPHIA, MISS.  
(mailing address)

WELL LOCATION:

sec. 28 T. 12 N. R. 11 E.  
S W

7 miles North of Phila.  
(distance) (direction) (nearest town)

WELL PURPOSE: Home Use  
(home, irrigation, municipal, industrial)

WELL COMPLETION DATA:

- (1) diameter (inches) 2"
- (2) total depth (feet) 428
- (3) static water level (feet) 82 below above top of ground.

(4) casing Gav. 210  
(material) (depth)  
If telescope see back.  
(size)

(5) screen None  
(length) (depth to top)  
(size) (material)


(6) pump 1 3.5  
(HP) (yield gpm)

REA  
(type power)  
(7) electric log NO  
(yes or no)

(organization running log)


(8) how well bottom plugged  
Open

DRILLERS REMARKS:

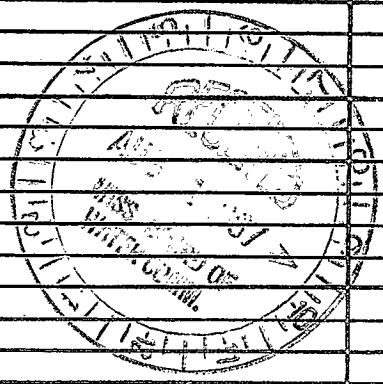

If well telescopes please sketch and show depths.

GROUND LEVEL

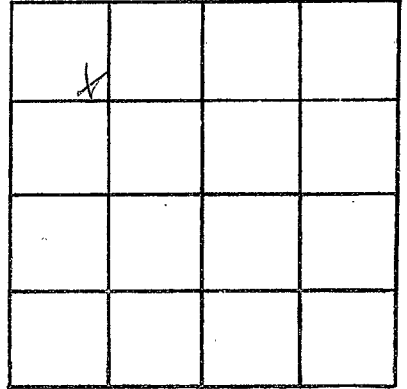

SECTION 28

Please indicate well location X.

ADDITIONAL INFORMATION

If more than one screen, show locations of each on sketch.