

3 13T

CODED

Neshoba  
B 3  
9-67

MISSISSIPPI  
BOARD OF WATER COMMISSIONERS  
416 North State Street  
Jackson, Mississippi 39201

WATER WELL DRILLERS LOG

9-18 19 67 OGLETREE DRILLING NESHOBA  
date well completed firm name county well located

LANDOWNER: GIRTH ATKINSON

description of formations encountered	from	to
	RED CLAY	0
BLUE CHALK	12	18

RT. 6

PHILADELPHIA, MISS.  
(mailing address)

WELL LOCATION:

sec. 23 T 12 N R 11 E  
8 miles North Phila.  
(distance) (direction) (nearest town)

WELL PURPOSE: Home  
(home, irrigation, municipal, industrial)

WELL COMPLETION DATA:


- (1) diameter (inches) 2"
- (2) total depth (feet) 54'
- (3) static water level (feet) 30 below top of ground.
- (4) casing Gav. 49  
(material) (depth)  
if telescope see back.  
(size)
- (5) screen 5' 54-49  
(length) (depth to top)  
1 1/4 STAINLESS STEEL  
(size) (material)
- (6) pump 3/4 7.5  
(HP) (yield gpm)  
REA  
(type power)

CODED

(7) electric log \_\_\_\_\_  
(yes or no)  
(organization running log)

(8) how well bottom plugged POINTED

DRILLERS REMARKS:

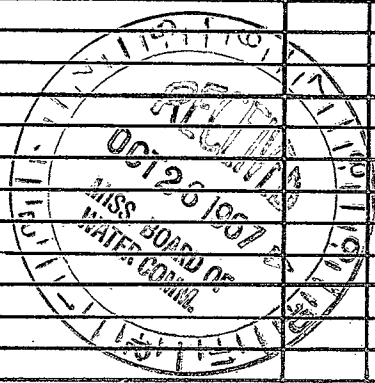

If well telescopes please sketch and show depths.

GROUND LEVEL

	X		

SECTION 23

Please indicate well location X.

ADDITIONAL INFORMATION

If more than one screen, show locations of each on sketch.